


T.IS.R.4 E.W.M.

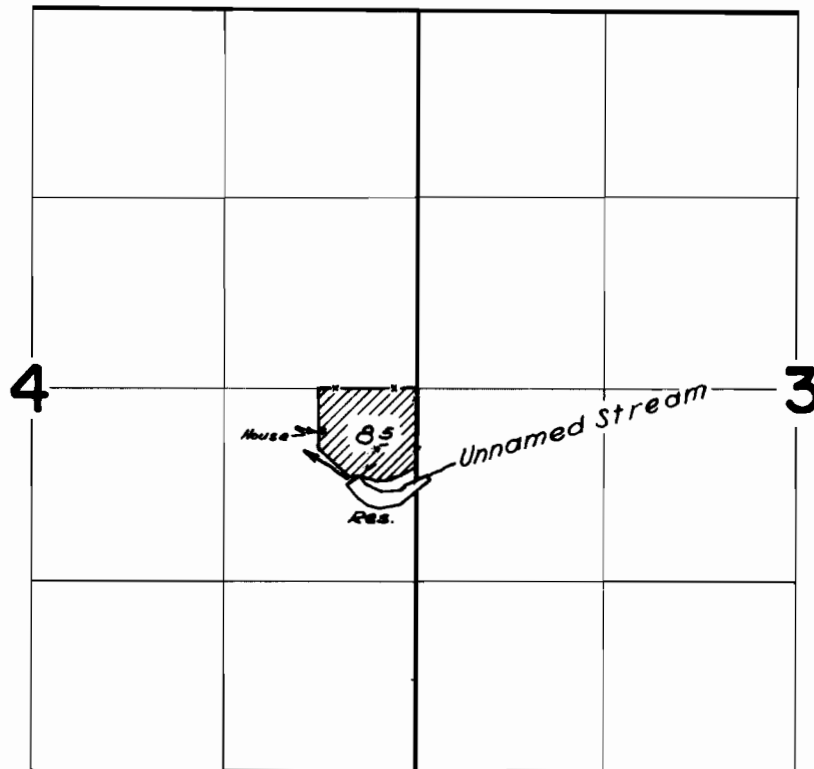

FINAL PROOF SURVEY
UNDER

R-32635 R-2230
Application No. 32636 Permit No. 26049
IN NAME OF

RAYMOND CRAMPTON

Surveyed August 18 1961, by C. O. Bartels