


T.IS.R.4 E.W.M.

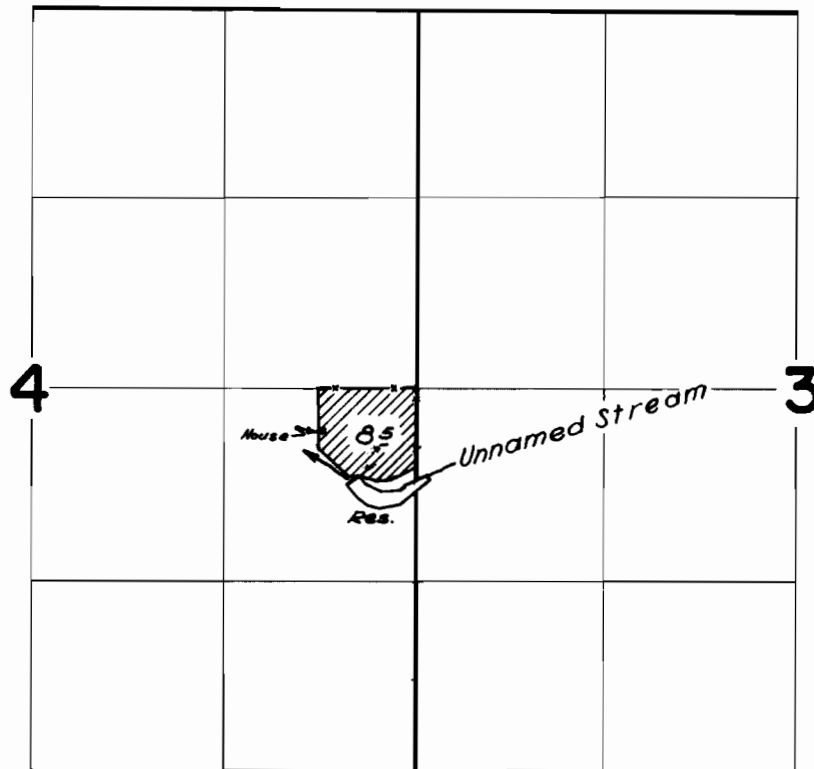

FINAL PROOF SURVEY
UNDER

Application No. **R-32635** **32636** Permit No. **R-2230** **26049**
IN NAME OF

RAYMOND CRAMPTON

Surveyed *August 18 1961*, by *C. O. Bartels*