


T. 7S.R. 4 W. W.M.

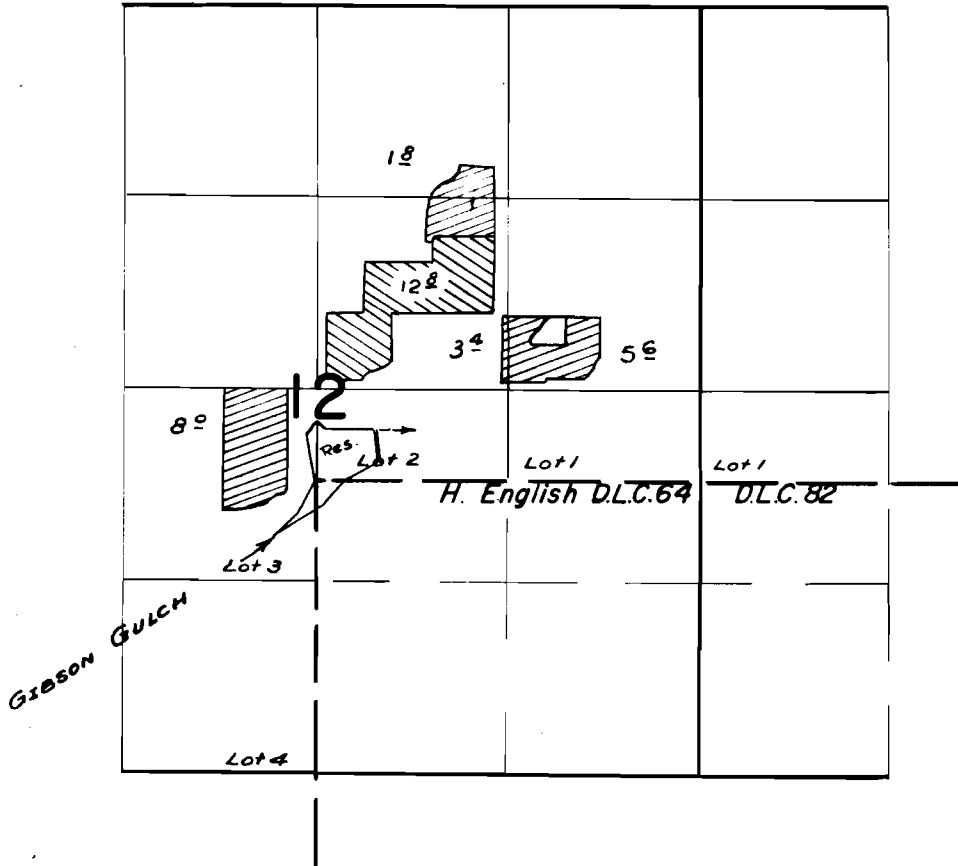

FINAL PROOF SURVEY
UNDER

Application No. 29901 Permit No. 23681
P-29900 P-1763
IN NAME OF

REX, V.L., FRED & DUANE GIBSON

Surveyed 23 MAR 1961, by Tom Bishop

1961-B
DFP-2D-36