


# T.6 & 7S.R.5 W.W.M.

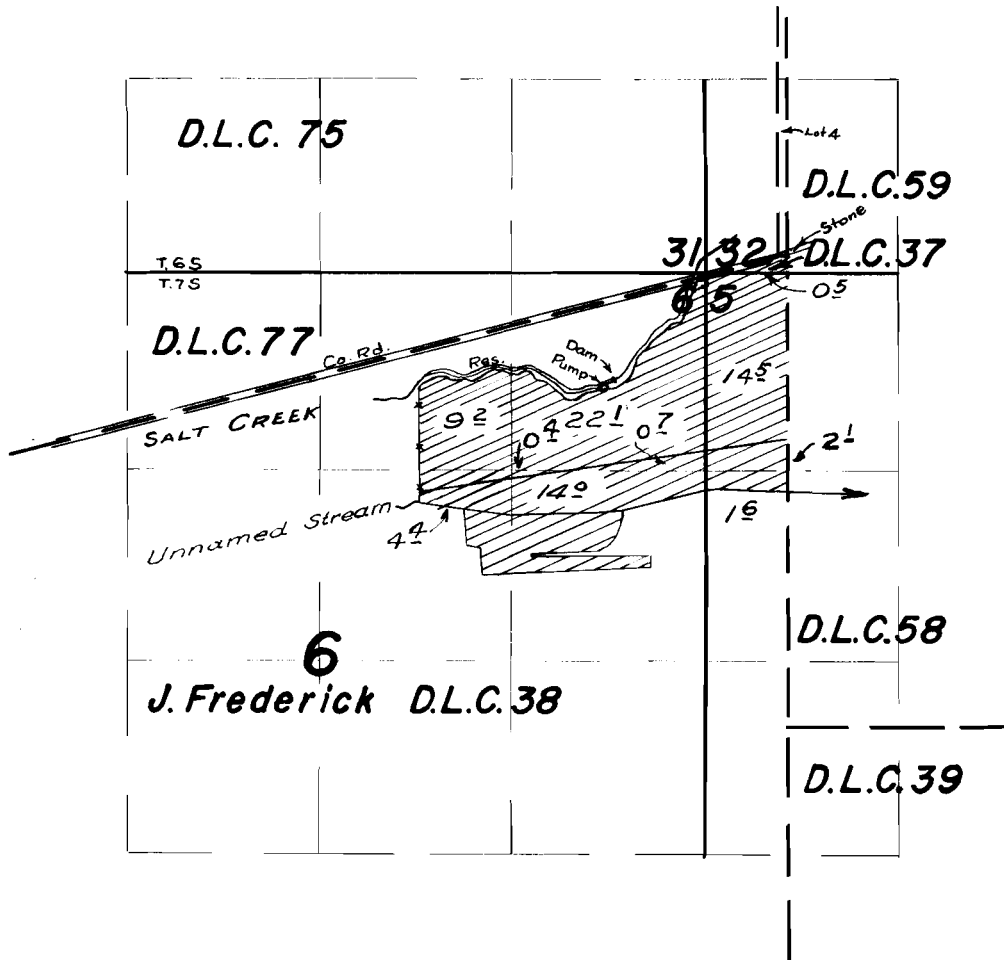

## FINAL PROOF SURVEY UNDER

R-32278      R-2123  
Application No. 32279      Permit No. 25458  
IN NAME OF

JOHN HOCKSTRE

Surveyed 24 MAR. 1961, by *M. Bish*