


T.6 & 7S.R.5 W.W.M.

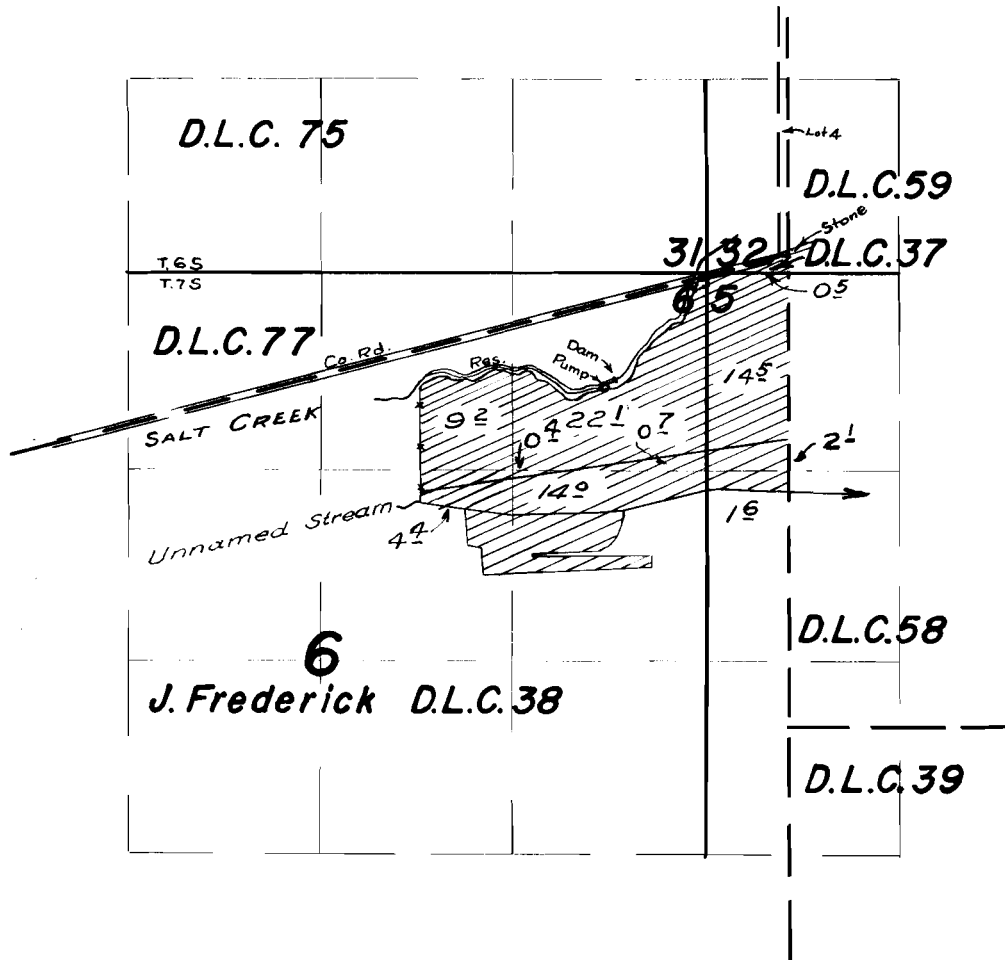

FINAL PROOF SURVEY UNDER

R-32278 R-2123
Application No. 32279 Permit No. 25458
IN NAME OF

JOHN HOCKSTRE

Surveyed 24 MAR. 1961, by *M. Bish*