


T. 15. R. 9 W. W. M.

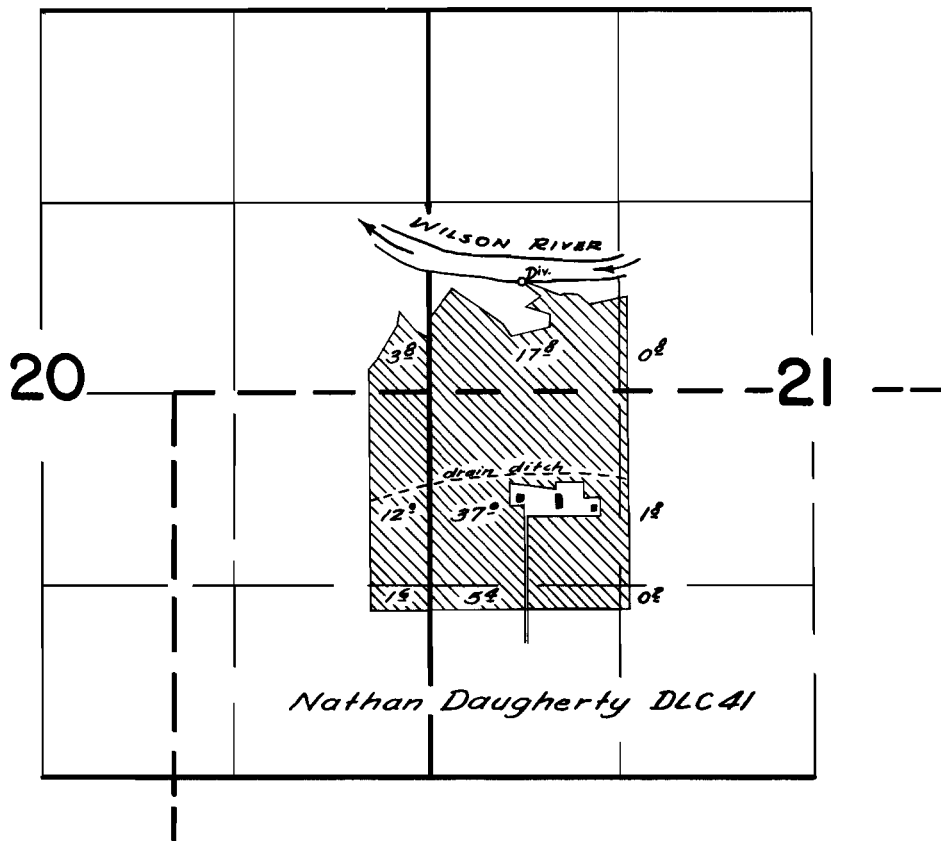

FINAL PROOF SURVEY
UNDER

Application No. 27125 Permit No. 21338
IN NAME OF

OTTO SCHILD

Surveyed April 17, 1961, by R. H. JACKSON