


T.3S.R.9W.W.M.

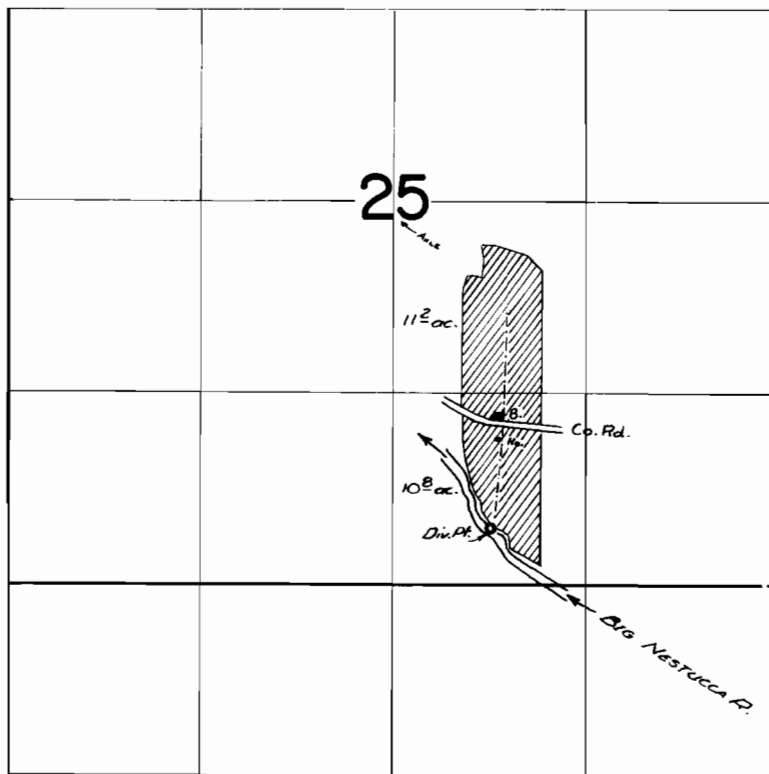

**FINAL PROOF SURVEY**  
UNDER

Application No. 30524 Permit No. 24034  
IN NAME OF

ROY A. & AWANNA R. FLETCHER

21 April '59  
Surveyed 26 June 1961, by M. Bish