


T.4SR9&10 W. W. M.

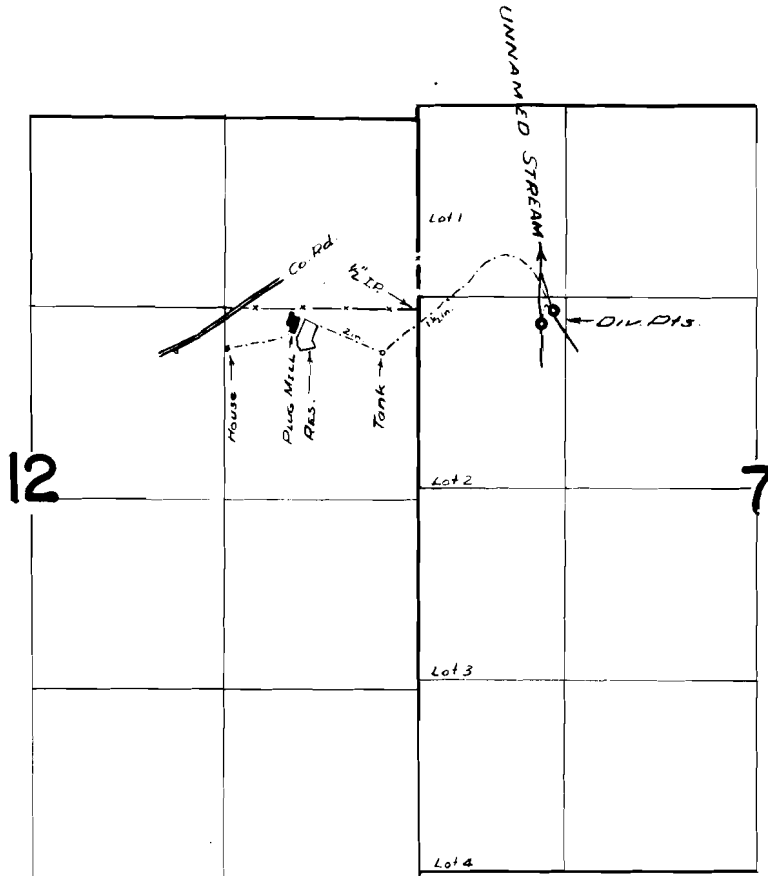

FINAL PROOF SURVEY UNDER

Application No. ³¹⁰⁰⁷ ~~P-30880~~ Permit No. ²⁴³⁸⁸ ~~P-1896~~
IN NAME OF

MARVIN B. & EVA L. NOBLE

Surveyed 28 June 1961, by *M. Bish*