


T.2S.R.9W.W.M.

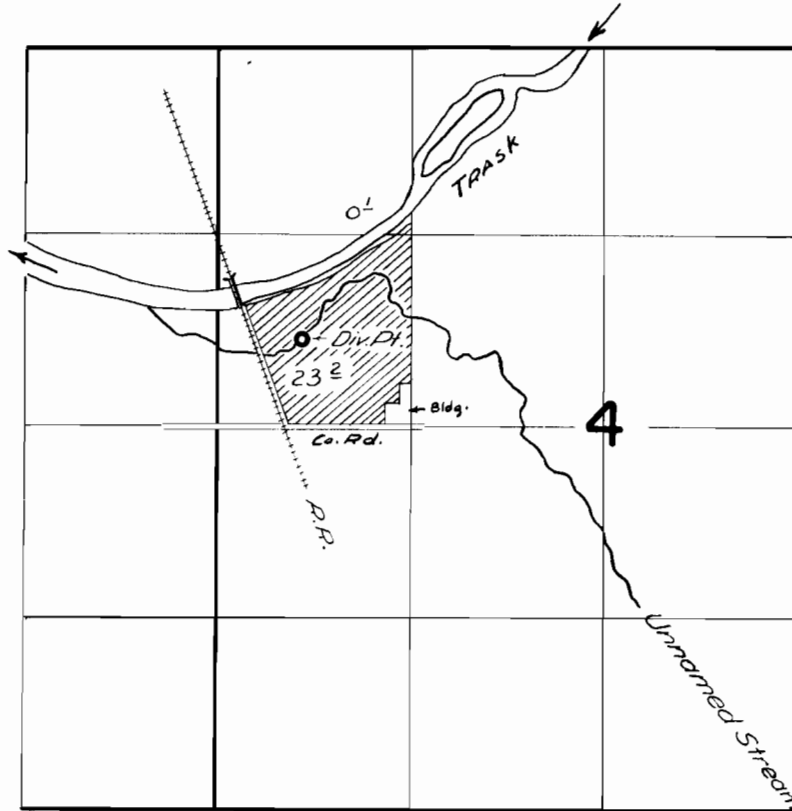

FINAL PROOF SURVEY UNDER

Application No. 31720 Permit No. 25009
IN NAME OF

FRITZ & HARRIETTE BAUMGARTNER

Surveyed 30 June 1961, by *Tru. Bush*