


T. 3S. R. 9W. W.M.

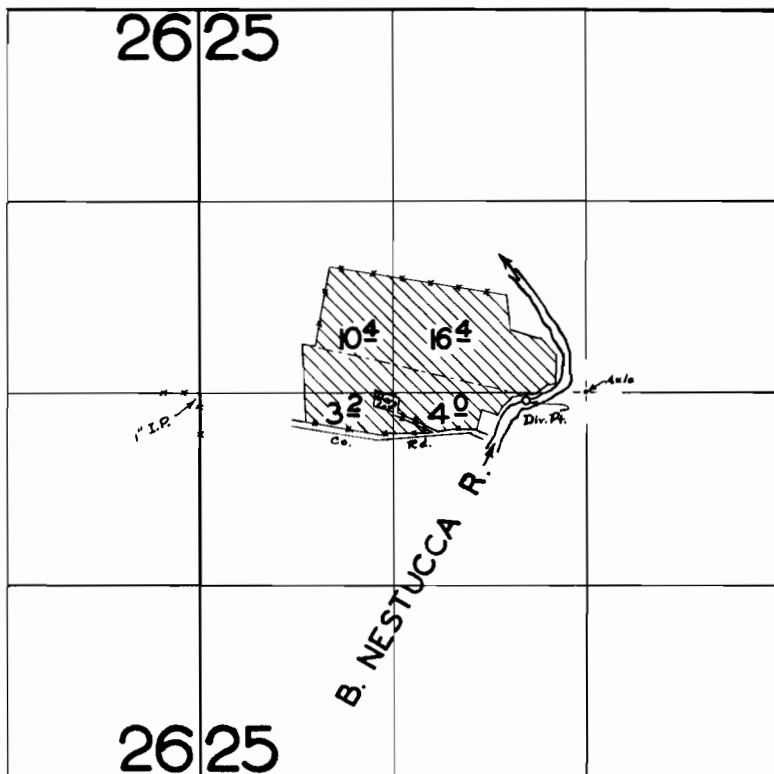

FINAL PROOF SURVEY
UNDER

Application No. 31919 Permit No. 25168
IN NAME OF

B. D. SHIPPEE

Surveyed APR. 21, 1959, by M. BISH