


T. 3 S. R. 9 W. W. M.

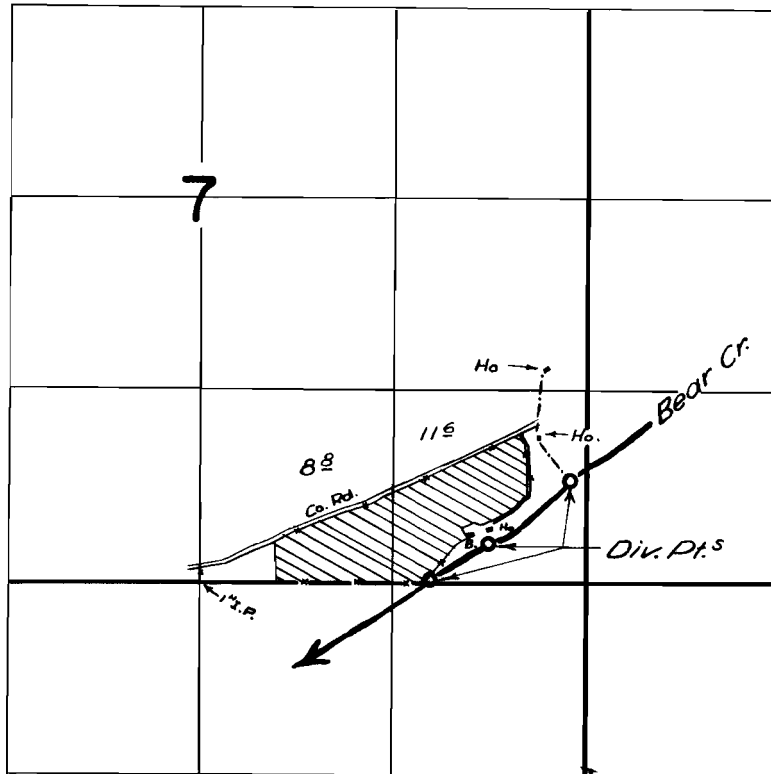

FINAL PROOF SURVEY
UNDER

Application No. 31838 Permit No. 25356
IN NAME OF

ULRICH WYSS, JR.

Surveyed 26 June 1961, by M. A. Bishop