
T.IS. R.9 W.W.M.

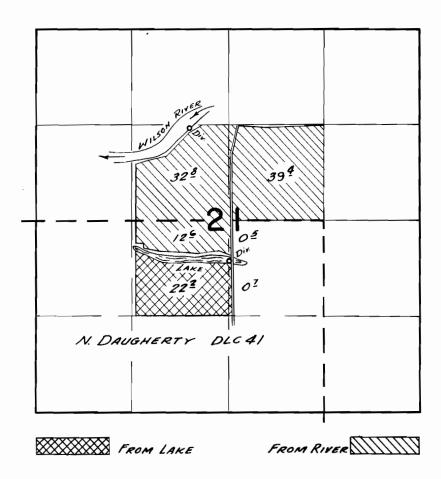

FINAL PROOF SURVEY

Application No. 32677. Permit No. 25801. IN NAME OF
HART BROS
Surveyed June 29 1961 by T. Jones