


T.4S.R.10W.W.M.

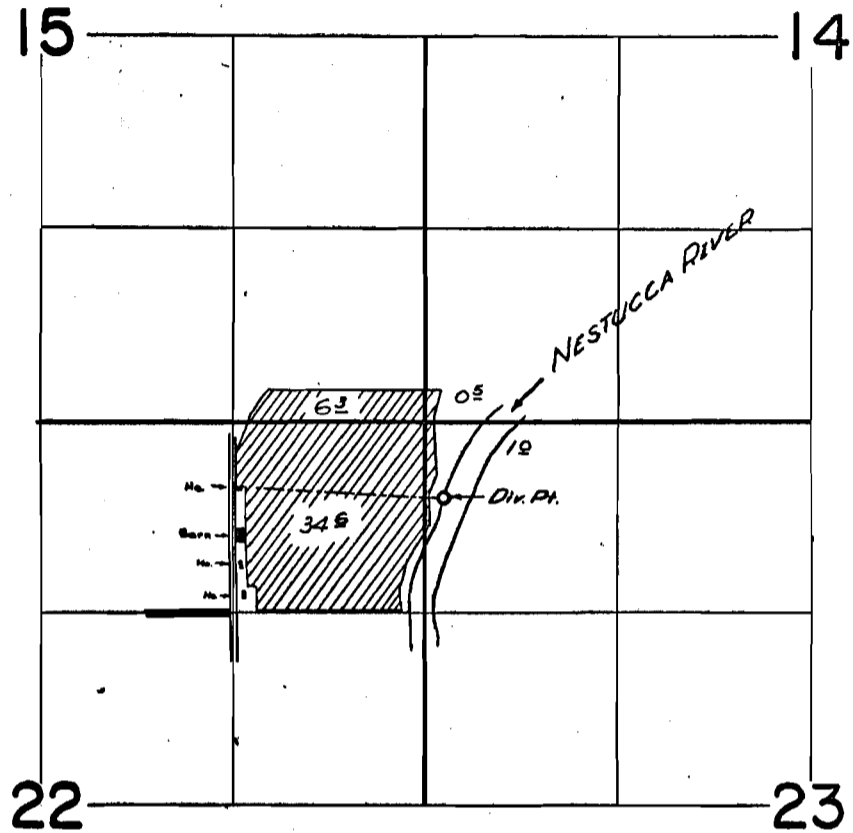

FINAL PROOF SURVEY UNDER

Application No. 33129 Permit No. 26200
IN NAME OF

DONELL D. BAILEY

Surveyed 28 June 1961, by T. B. Bish

4-10V