


T.4S.R.10W.W.M.

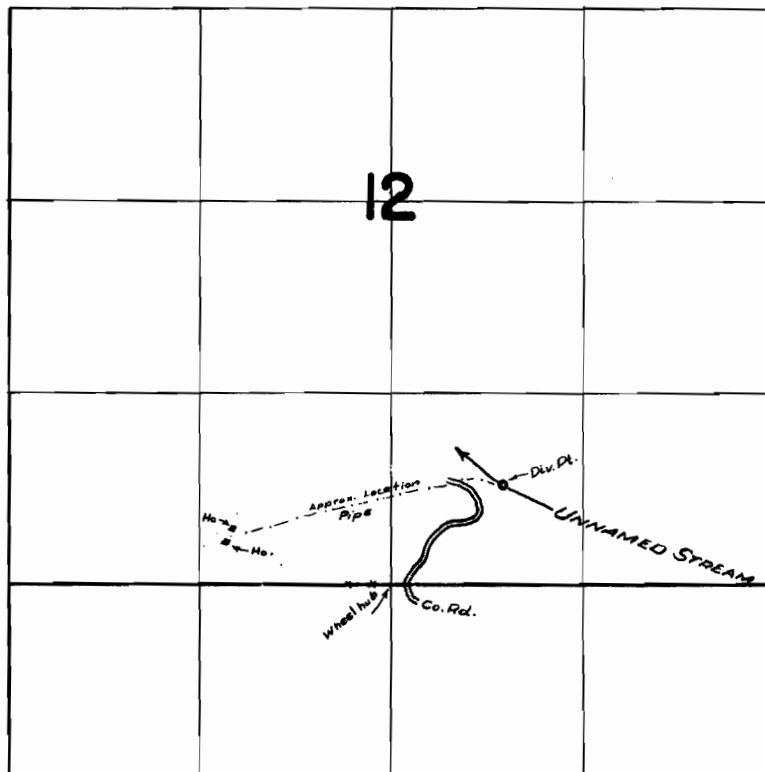

**FINAL PROOF SURVEY**  
UNDER

Application No. 33297 Permit No. 26444  
IN NAME OF

MIKE IHNAT

Surveyed 28 June 1961, by M. Bish