


T. 3 N. R. 33 E. W. M.

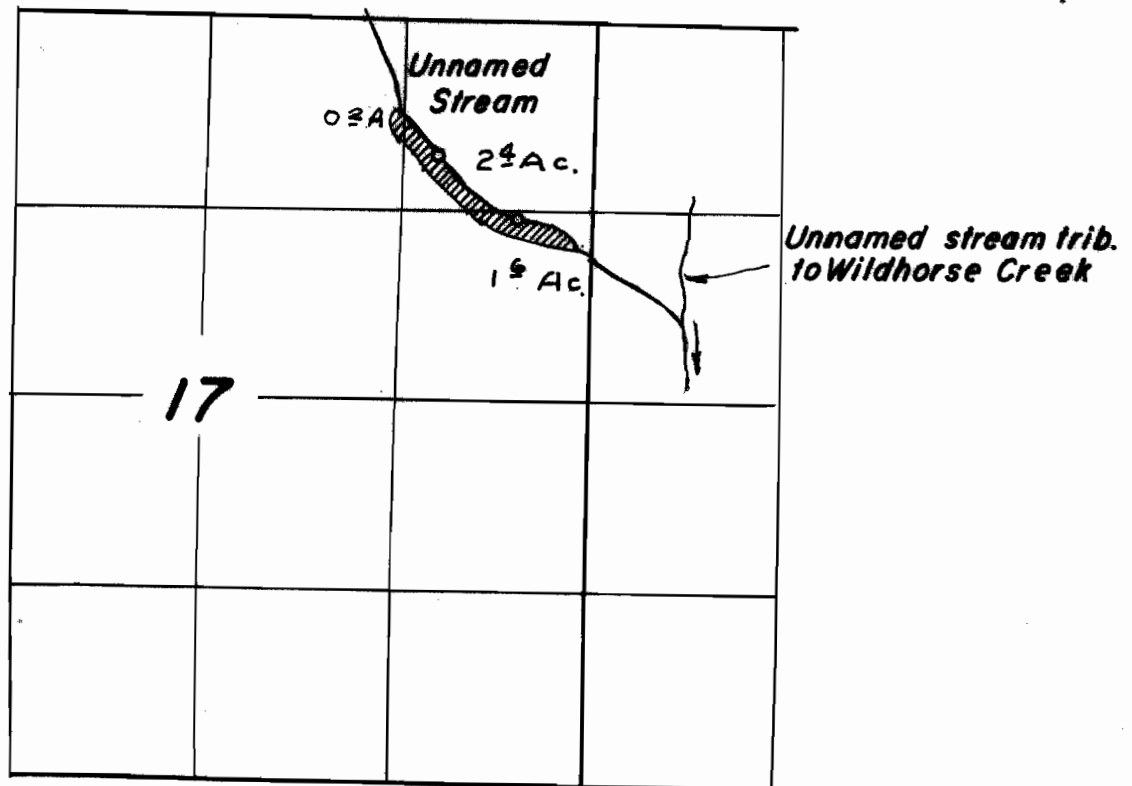

FINAL PROOF SURVEY
UNDER

Application No. 35114 Permit No. 27487
IN NAME OF

LULA MAY CRESSWELL

Surveyed May 2 1962, by R. Jackson