


R.I.S.R.4W.W.M.

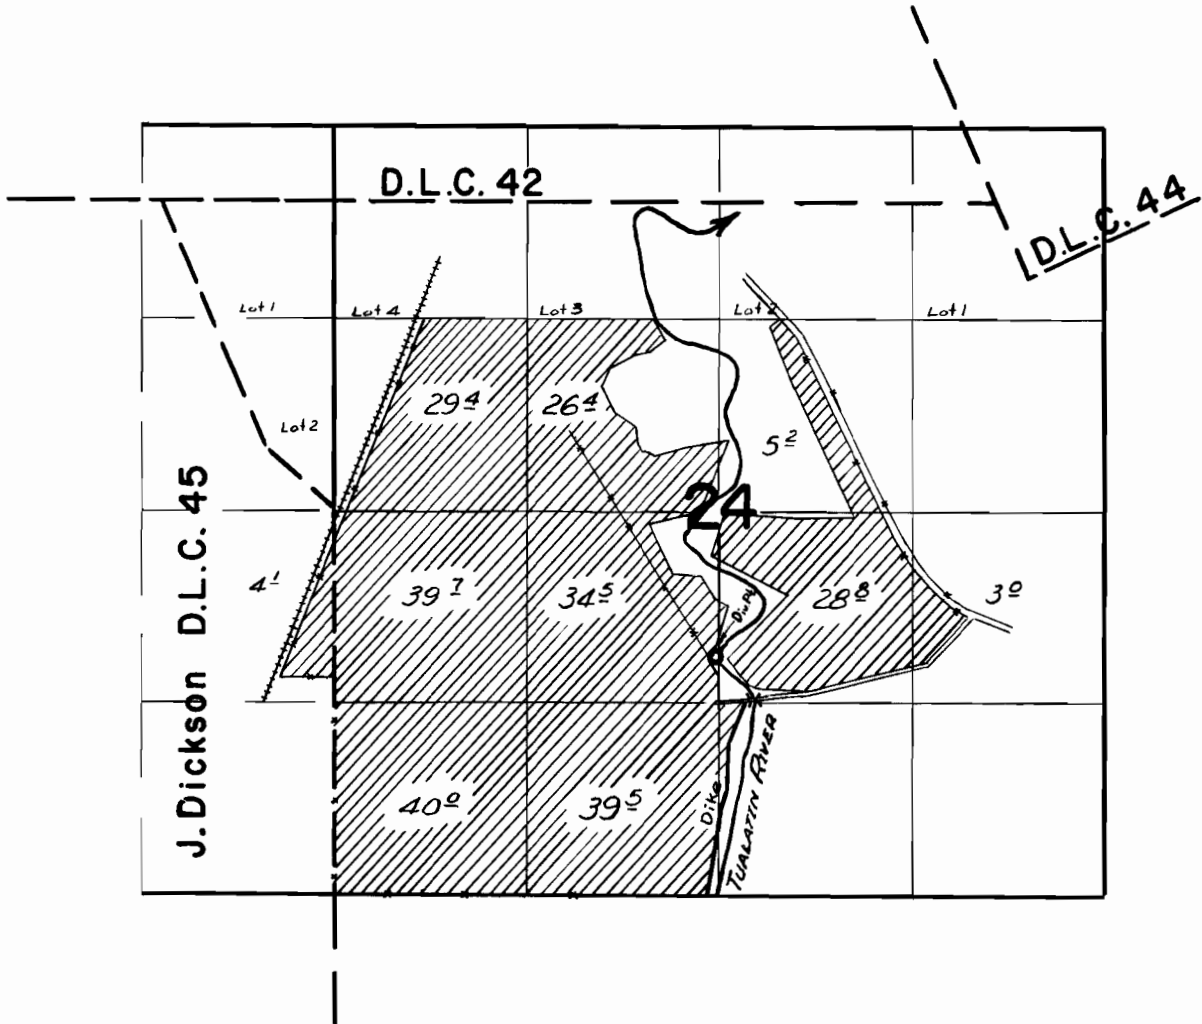

FINAL PROOF SURVEY
UNDER

Application No. 22553 Permit No. 18292
IN NAME OF

GEORGE J. ZURCHER

Surveyed 10 Aug. 1961, by M. Bish