


# T.I.S.R.4 W.W.M.

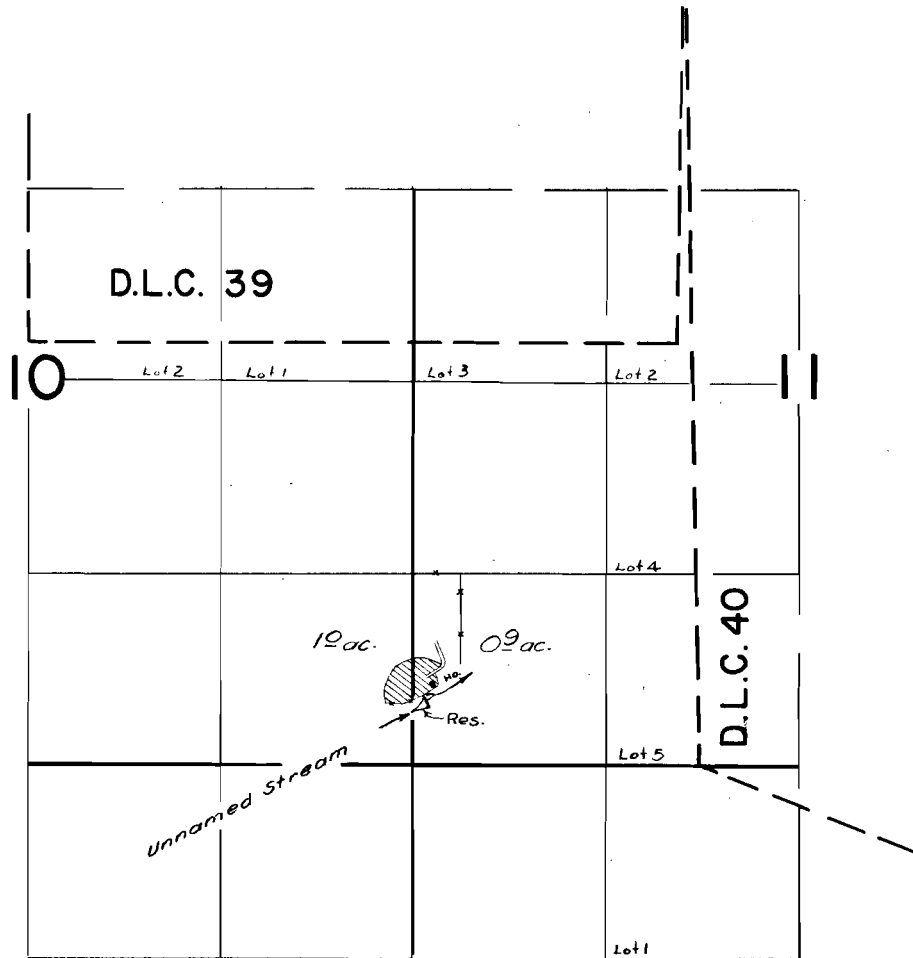

## FINAL PROOF SURVEY UNDER

Application No. 27526 Permit No. 21686  
R-27526 R-1413  
IN NAME OF

ROBERT F. TILSON

Surveyed 14 AUG. 1961, by M. Bish