


T.I.S.R.4W.W.M.

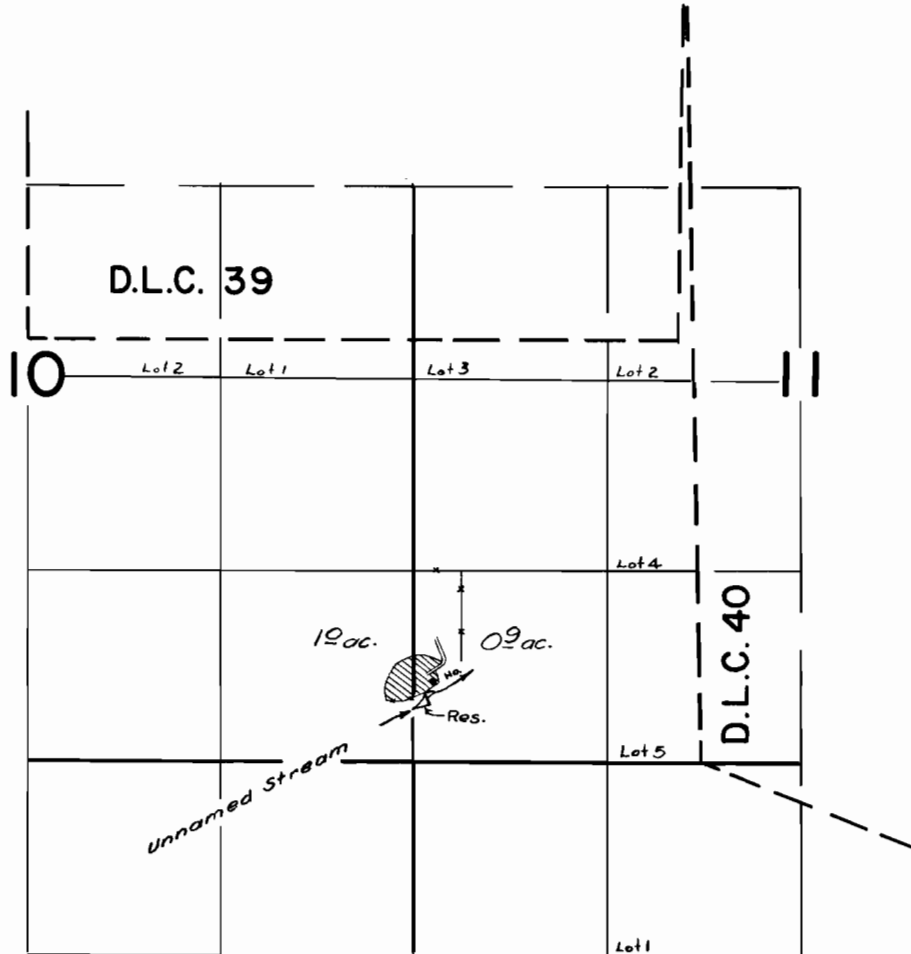

FINAL PROOF SURVEY
UNDER

Application No. 27526 Permit No. 21686
R-27526 R-1413
IN NAME OF

ROBERT F. TILSON

Surveyed 14 AUG. 1961, by M. Bish