


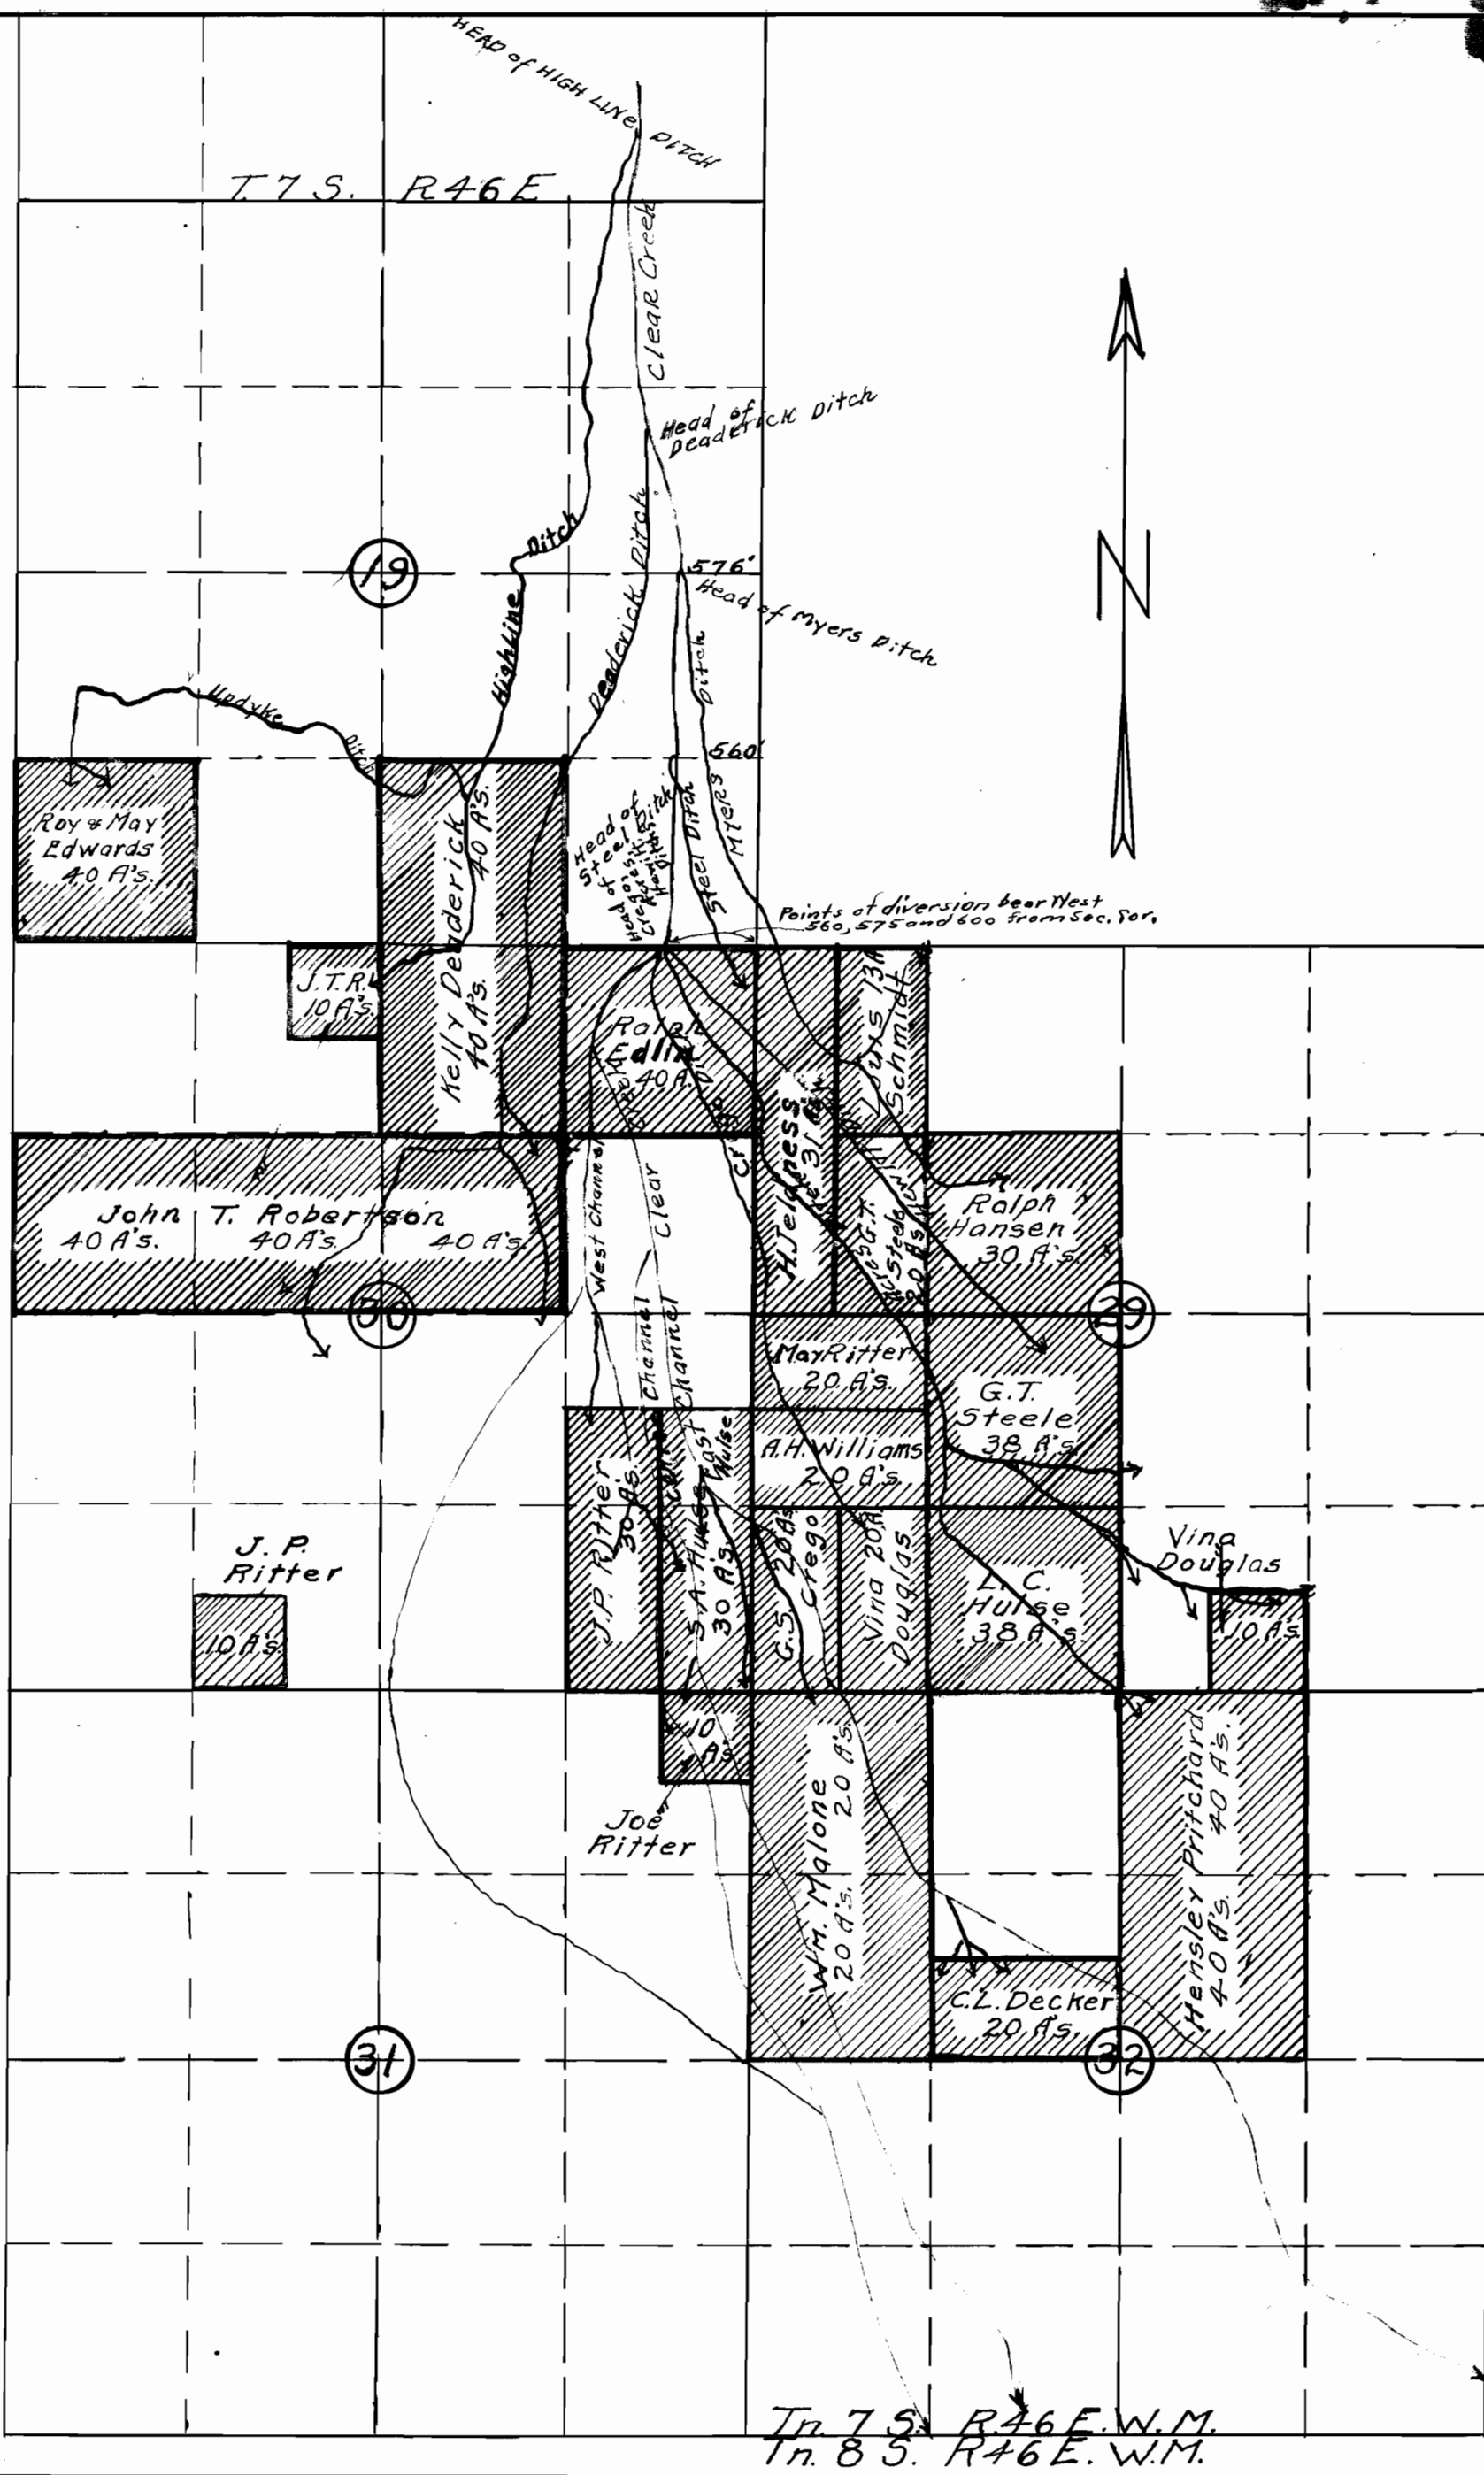

Map to accompany proof of
Appropriation of Water
Permit No. R-515
Clear Creek Reservoir Company
Halfway, Baker County, Oregon
Scale 1"=1200'
Map drawn by H.T. Swan, Baker Oregon

Phil H. Anderson
BAKER, ORE.