


T.7 S.R.46 E.W.M.

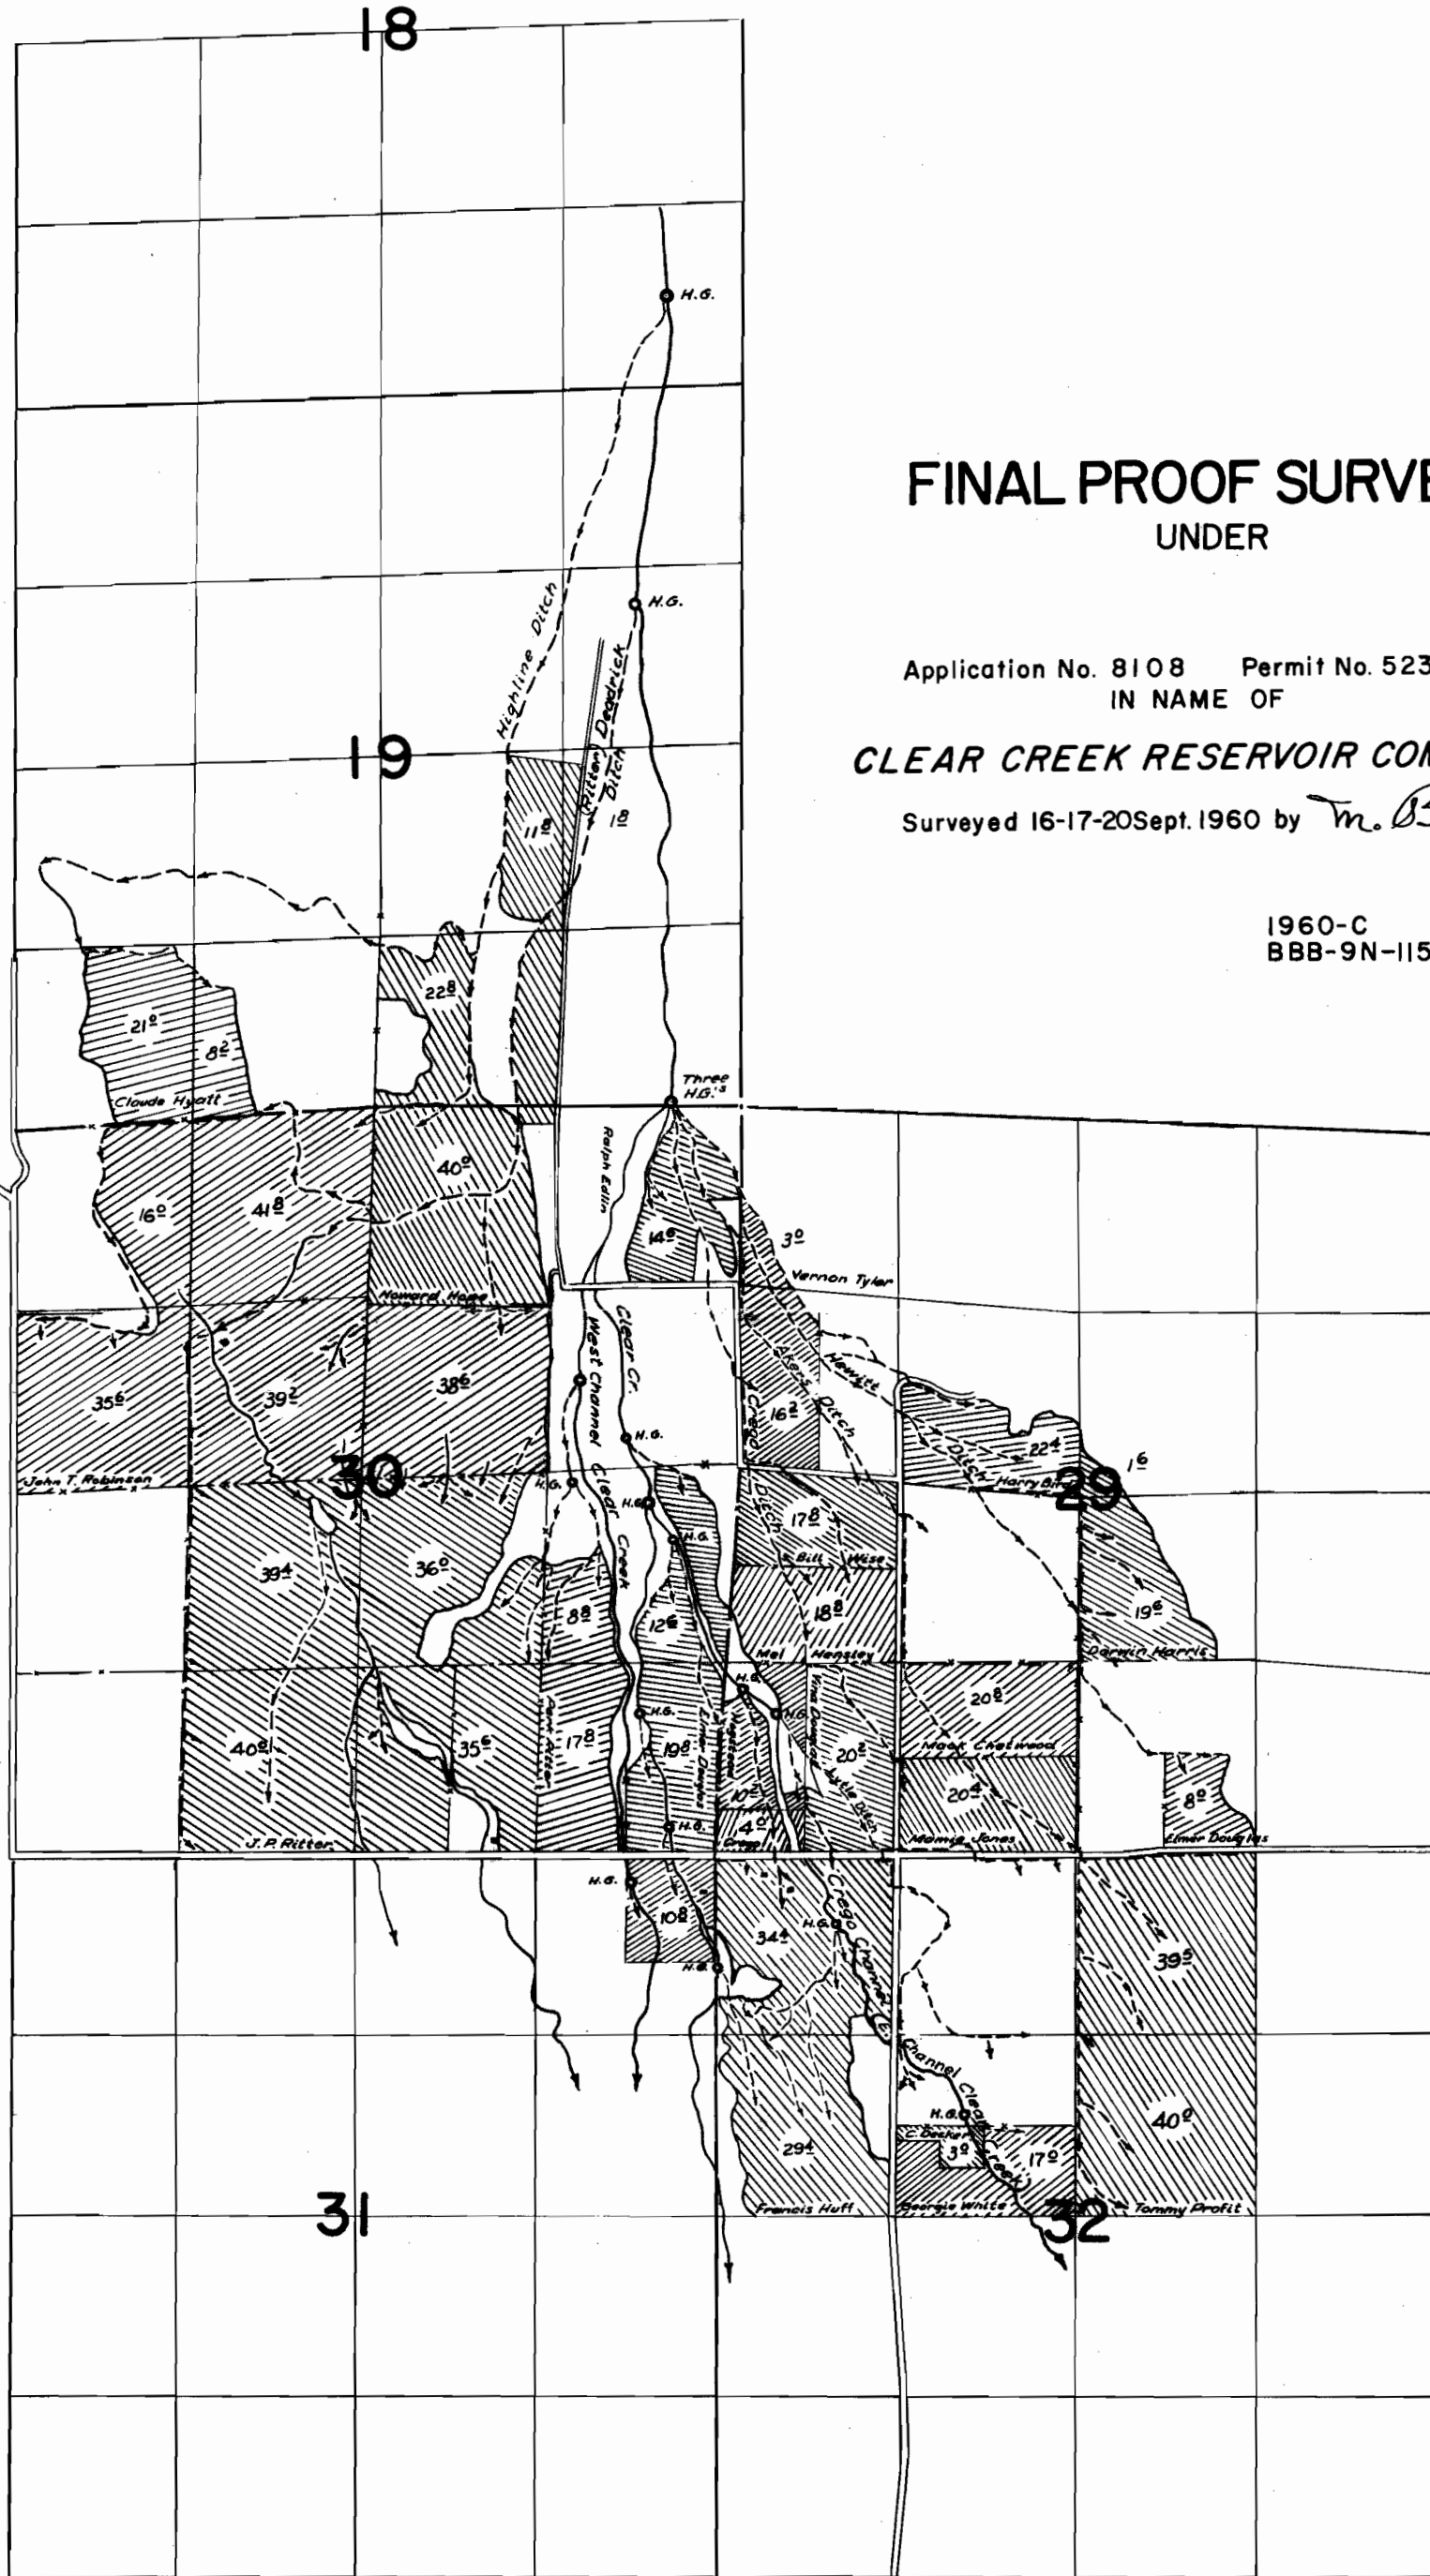

**FINAL PROOF SURVEY**  
UNDER

Application No. 8108 Permit No. 5234  
IN NAME OF

**CLEAR CREEK RESERVOIR COMPANY**

Surveyed 16-17-20 Sept. 1960 by *M. Bish*

1960-C  
BBB-9N-115