T.7&8S.R.46E.W.M.

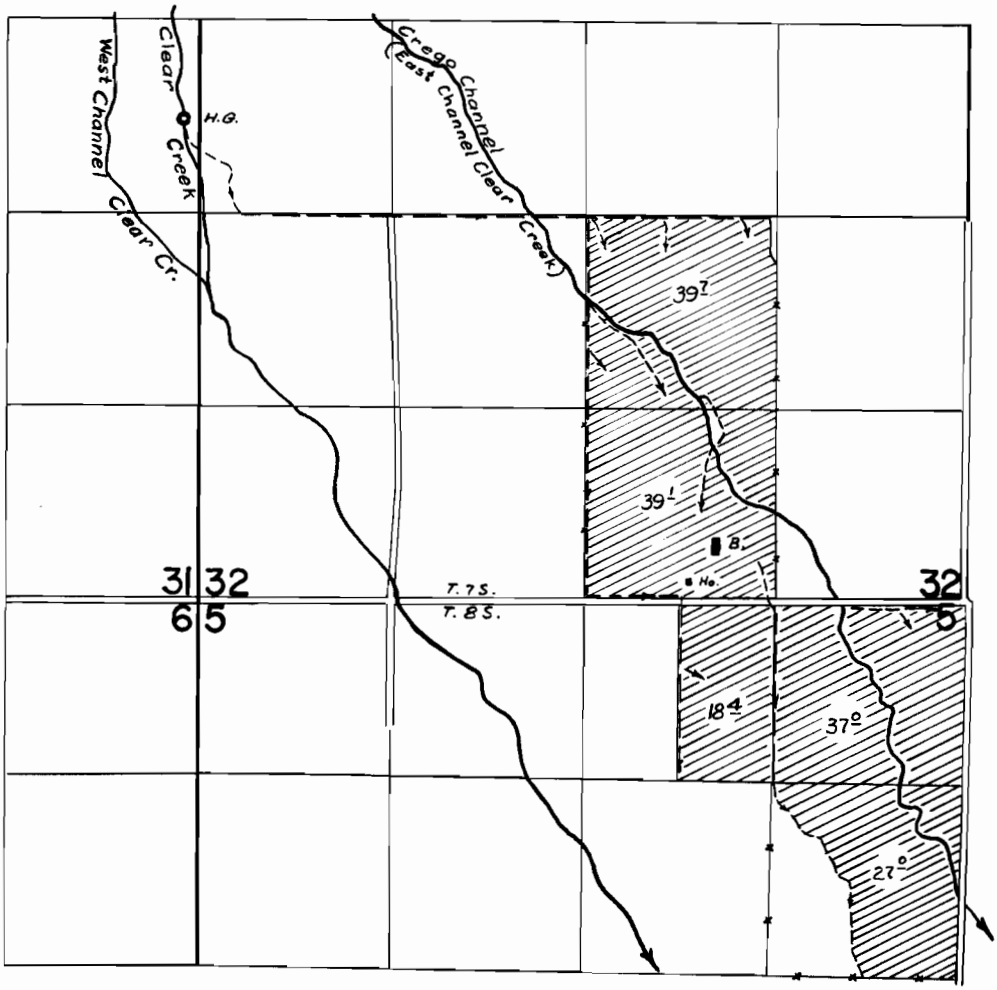

FINAL PROOF SURVEY
UNDER

Application No. 14305 Permit No. 106801
IN NAME OF

Surveyed 15 Sept. 1960, by M. Bish

1960-E
BBB-9N-115