


T. 7 S. R. 46 E. W. M.

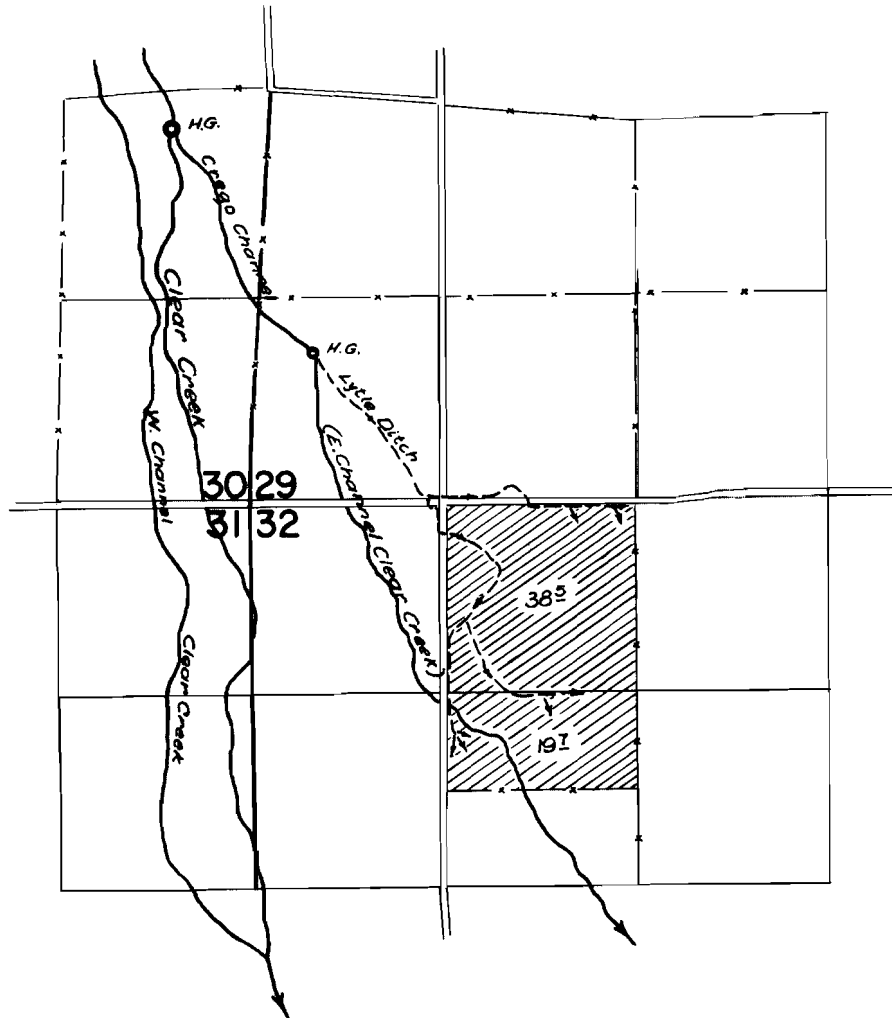

FINAL PROOF SURVEY
UNDER

Application No. 19362 Permit No. 14946
IN NAME OF

ELMER DOUGLAS

Surveyed 16 Sept. 1960, by m. Bish