


T14S. R.43E.WM.

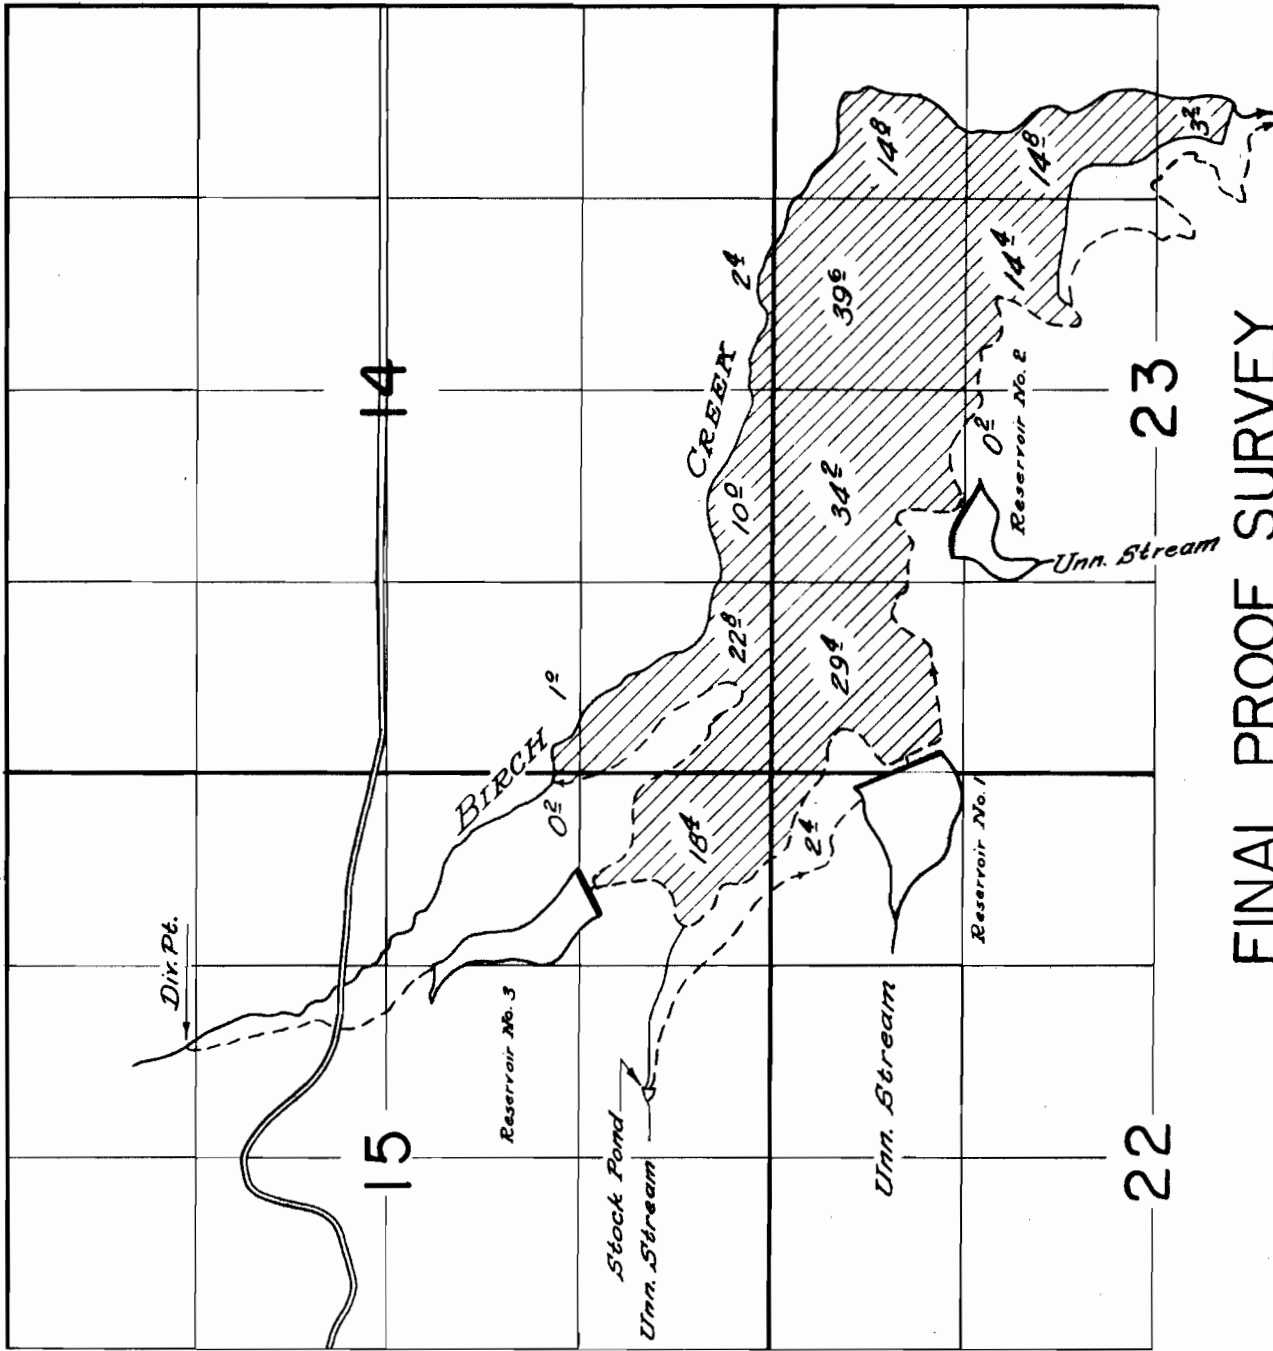

FINAL PROOF SURVEY
for

ESTATE OF KATHLEEN W. KIVETT

Application No. R-22548 Permit No. R-885
R-22549 17759
R-24198 R-1174
R-24199 R-29412
R-24200 R-1176
R-24201 R-26412 - R-1176 & R-26413 - R-26414

Surveyed Sept. 14, 1960 By C.O. Barak