T.14S. R.43E.W.M.

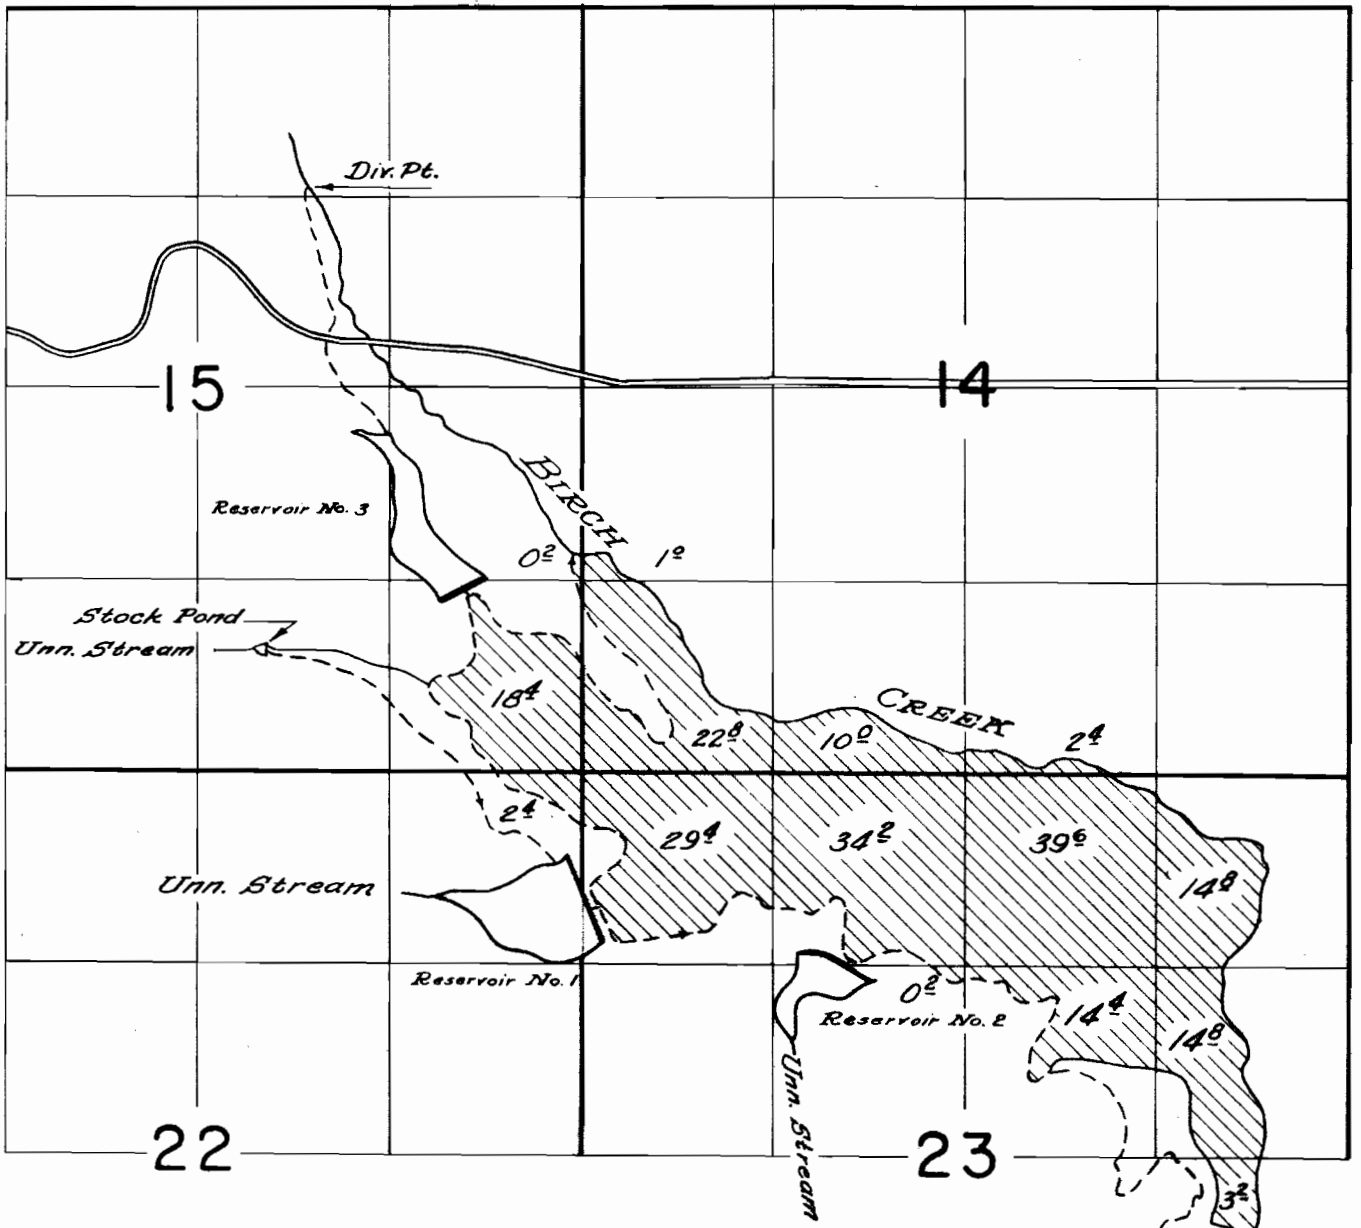

FINAL PROOF SURVEY

for

ESTATE OF KATHLEEN W. KIVETT

Application No. R-22548, 22549, R-26136, 26139, R-26140, 26141

Permit No. R-885, 17758, R-1174, 20412, R-1175, 20413 & R-26412 - R-1176 & 26143 - 20414

Surveyed Sept. 14, 1960 By C.O. Bartels