


T.14S. R.43E.W.M.

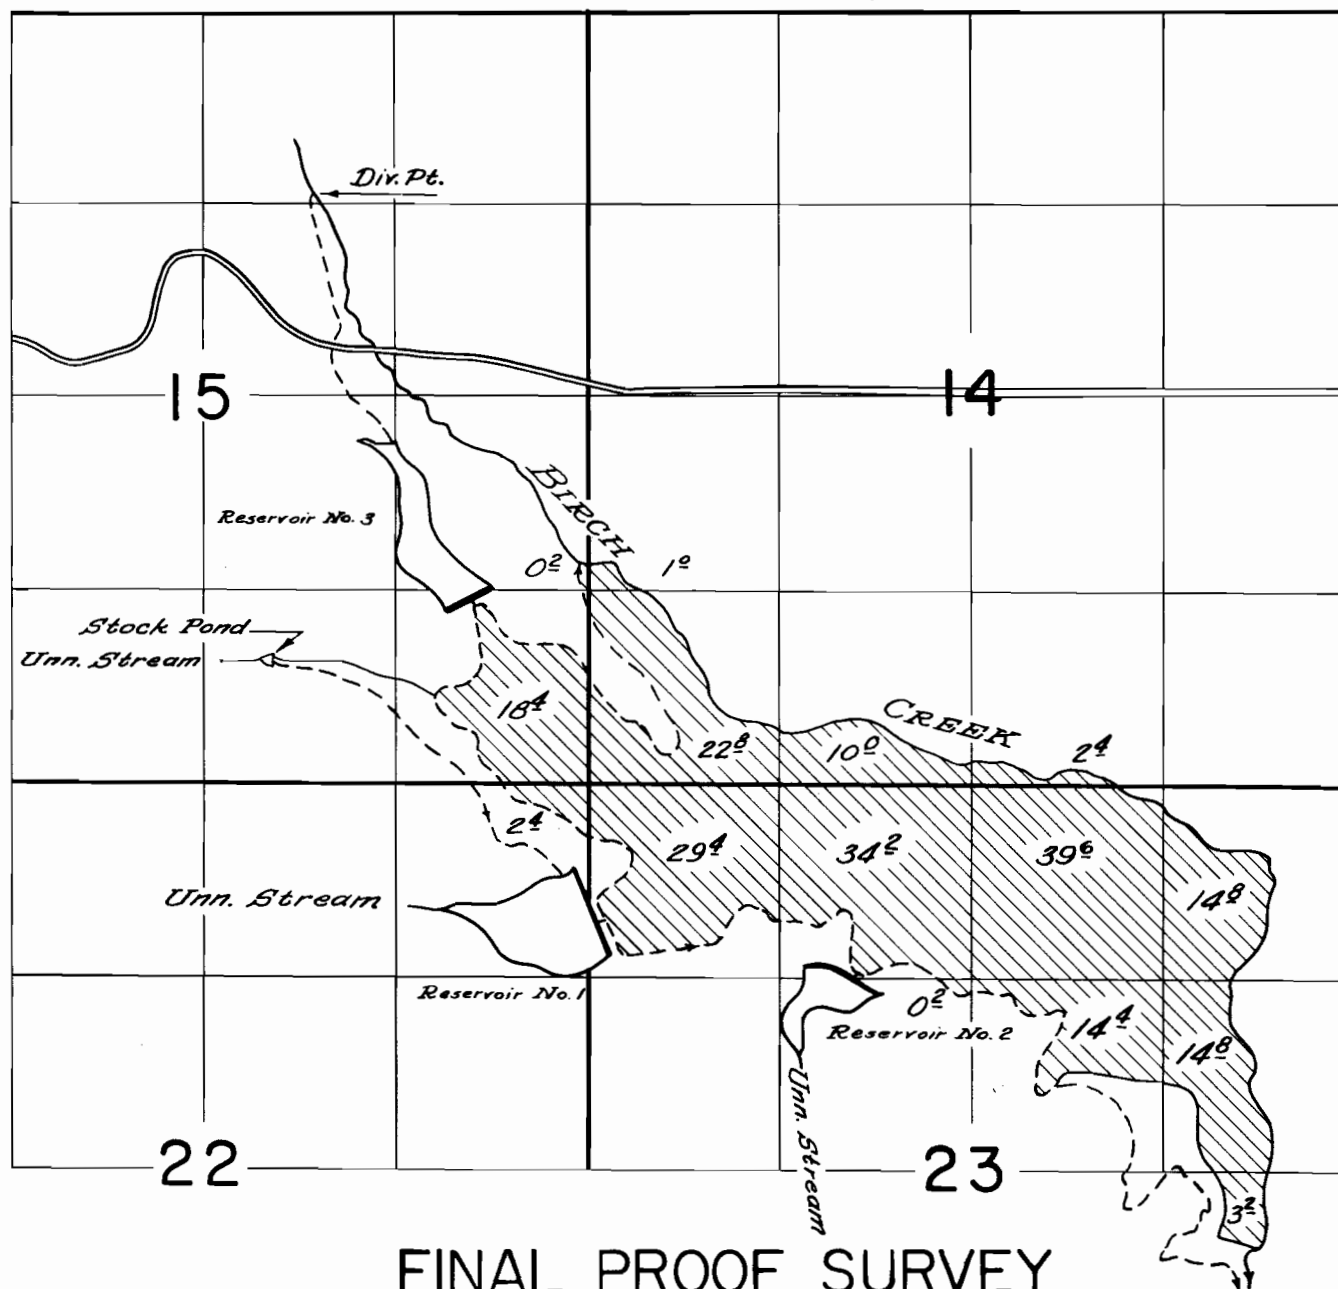

FINAL PROOF SURVEY
for

ESTATE OF KATHLEEN W. KIVETT

Application No. R-22548

Permit No. R-885

22549

17758

R-26138

R-1174

26139

20412

R-26140

R-1175

26141

20413

Surveyed Sept. 14, 1960 By C.O. Bartels

& R-26412 - R-1176 & 26143 - 20414