


T14S. R.43E.W.M.

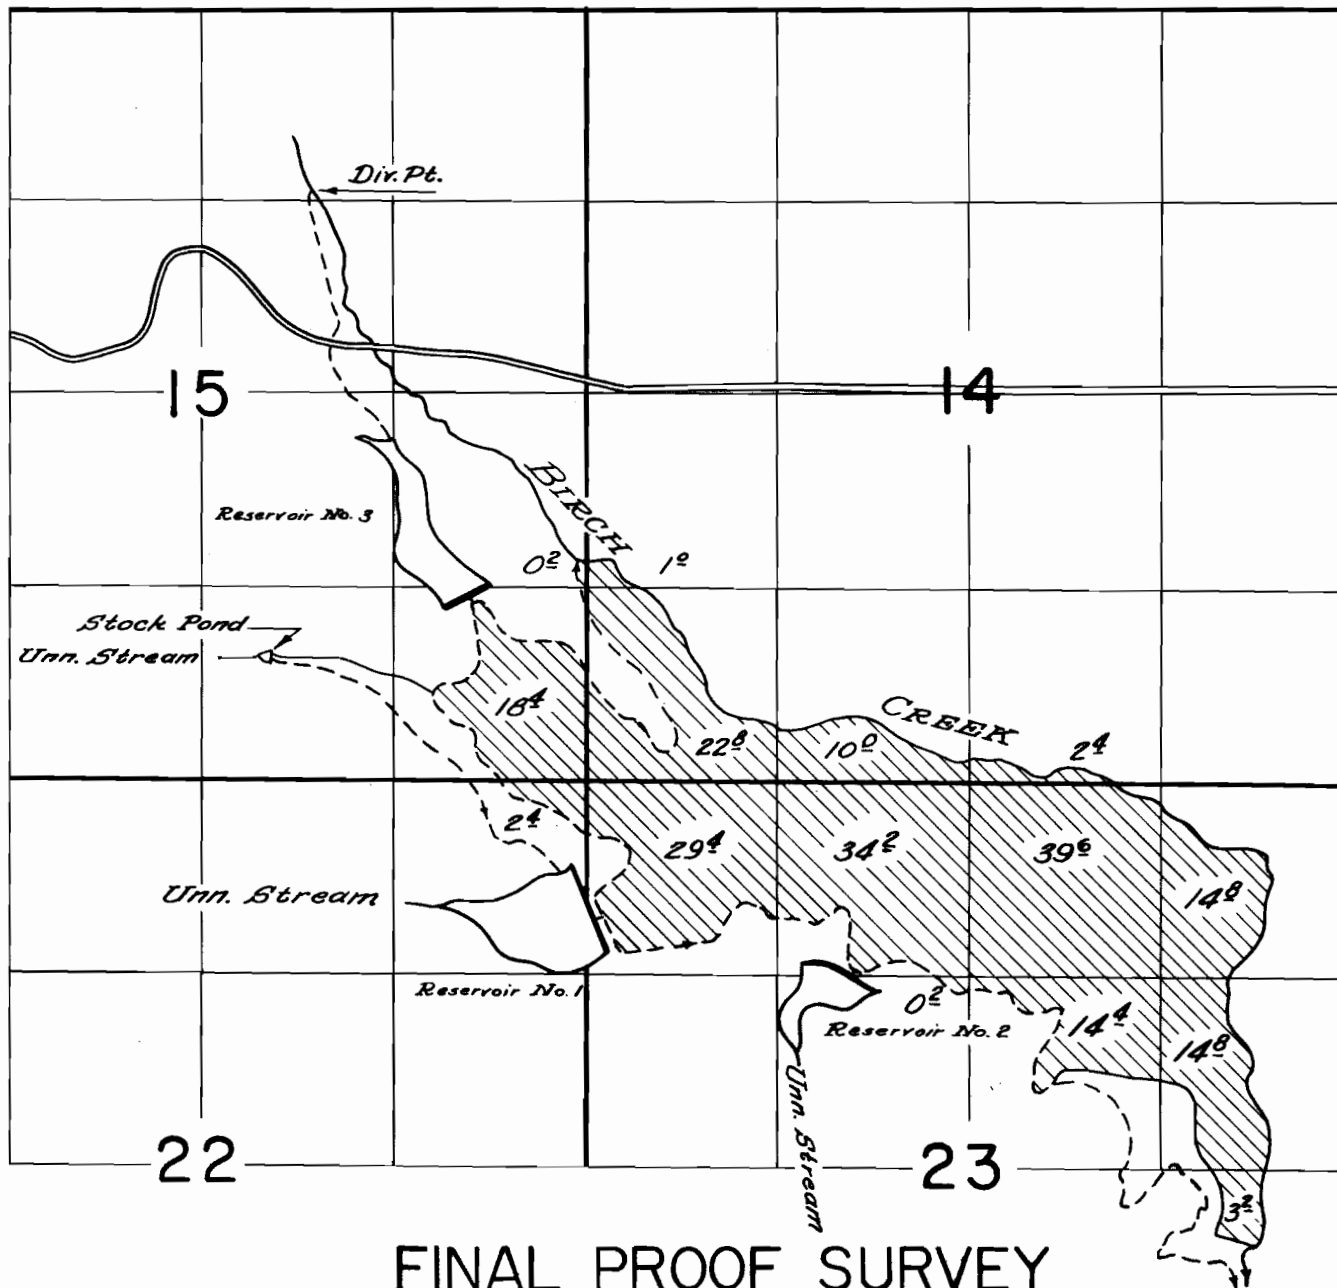

FINAL PROOF SURVEY
for

ESTATE OF KATHLEEN W. KIVETT

Application No. R-22548

Permit No. R-805

22549

17758

R-26138

R-1174

R-26139

R-20412

R-26140

R-20413

26141

R-26412

R-1176 & R-26143-20414

Surveyed Sept. 14, 1960 By C.O. Bartels