


T.12S.R. 5W.W.M.

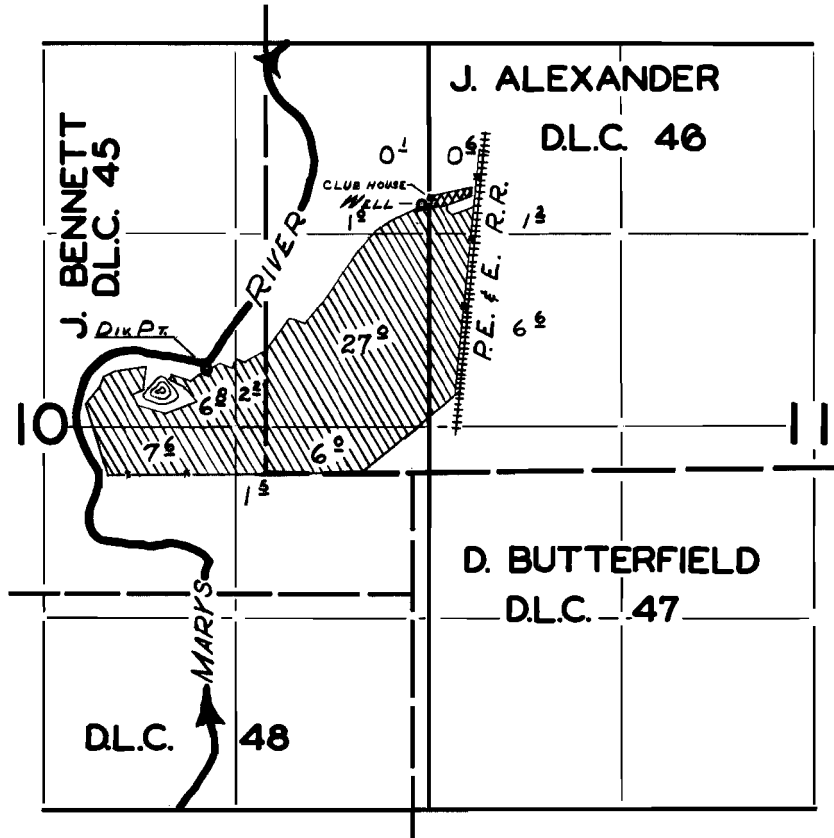

FINAL PROOF SURVEY
UNDER

Application No. G-766 31200..... Permit No. G-658 25133..... 
IN NAME OF

.....MODE G. HOSELTON.....

Surveyed Mar. 29, 1961., by C.O. BARTELS.....