


# T.12S.R.6W.W.M.

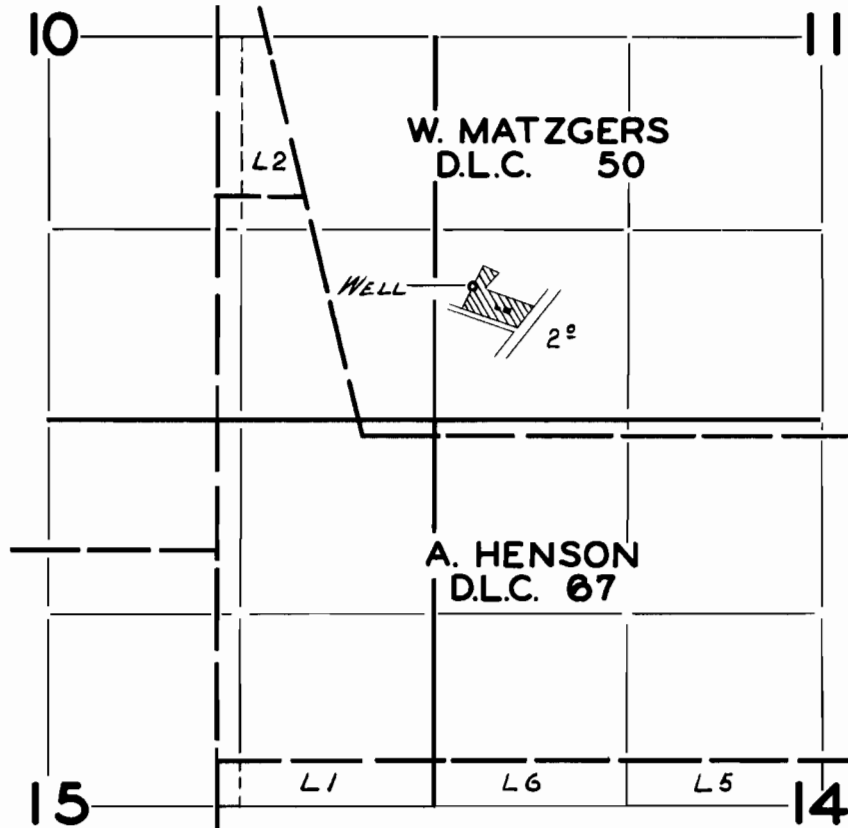

## FINAL PROOF SURVEY UNDER

Application No. **G-983** Permit No. **G-870**...  
IN NAME OF

**OLLIE & HARRY HARDENBURGER**

Surveyed *MAY 31 1961*, by *C.O. BARTELS*....