


T.14 S. R. 5 W. W. M.

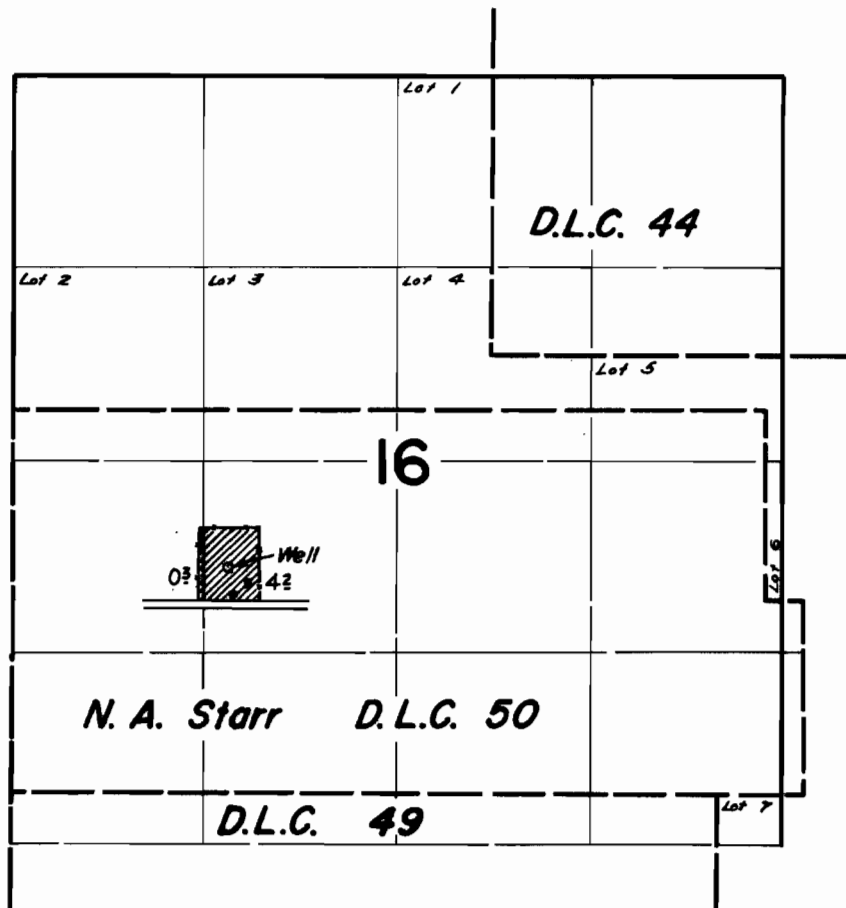

FINAL PROOF SURVEY
UNDER

Application No. G-1392 Permit No. G-1256
IN NAME OF

LAWRENCE F. CARDA

Surveyed Sept. 6, 1961, by C. O. Bartels