


T.14 S.R.6 W.W.M.

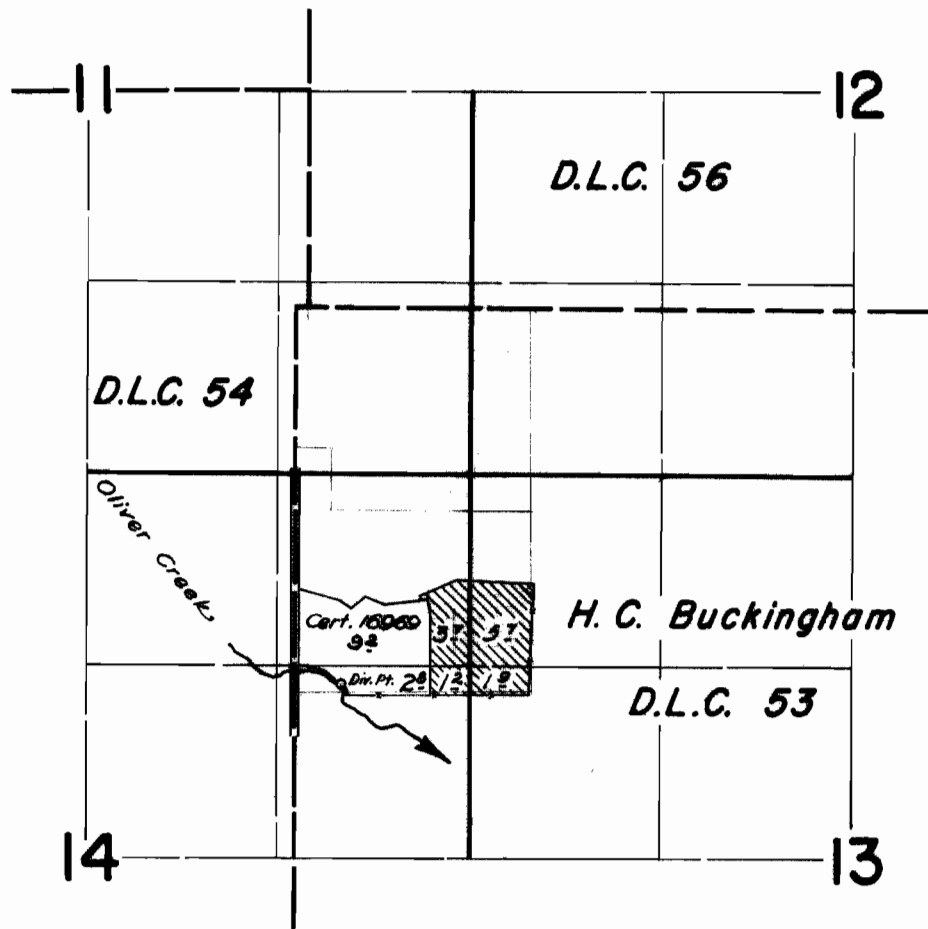

FINAL PROOF SURVEY UNDER

Application No. 33743 Permit No. 26647
IN NAME OF

TOTTEN BROTHERS

Surveyed Sept. 6, 1961, by C. O. Bartels