


T.3S.R.2E.W.M.

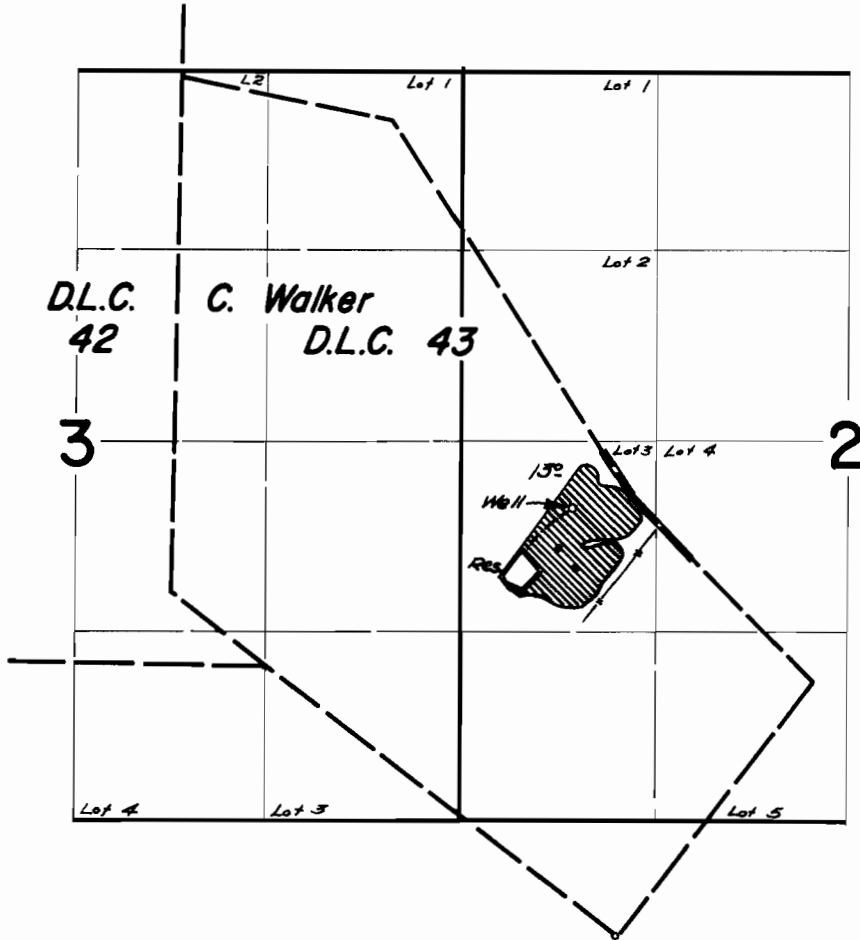

FINAL PROOF SURVEY UNDER

Application No. G-1496 Permit No. G-1371
IN NAME OF

FLOYD E. FOWLER

Surveyed April 26, 1961, by [Signature]