


T.3&4 S.R. I.E.W.M.

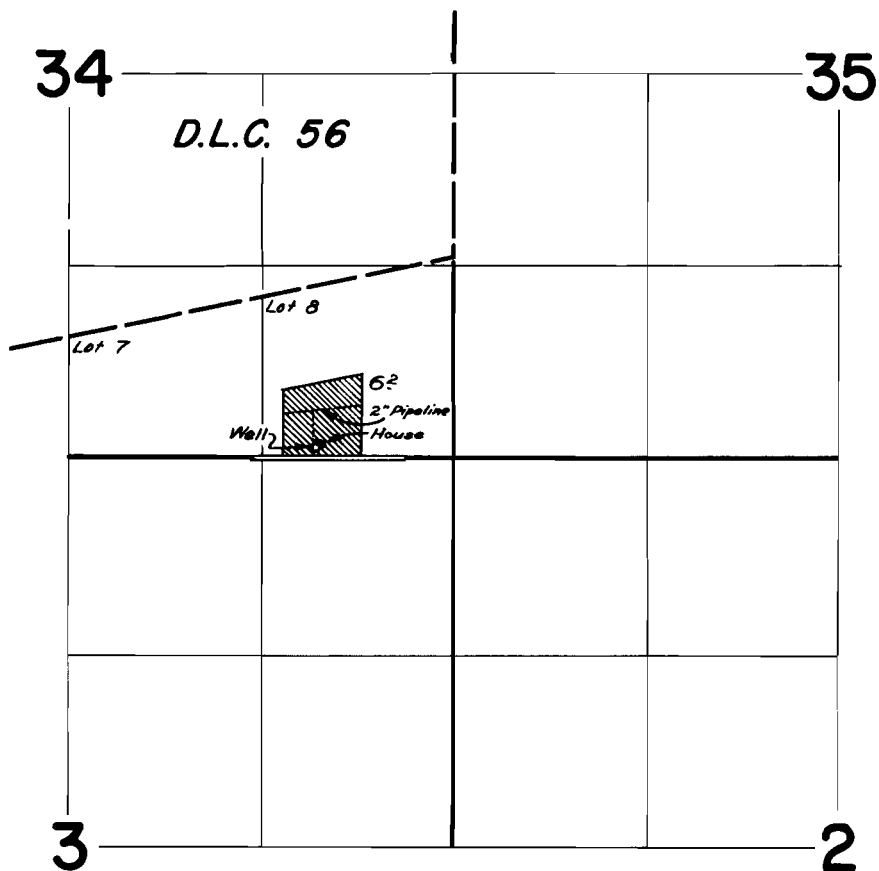

FINAL PROOF SURVEY UNDER

Application No. ~~9-1875~~ Permit No. ~~9-1718~~....
IN NAME OF

..... HAROLD..... FISH.....

Surveyed April 26 1961... by

[Signature]