


T.3S.R.9E.W.M.

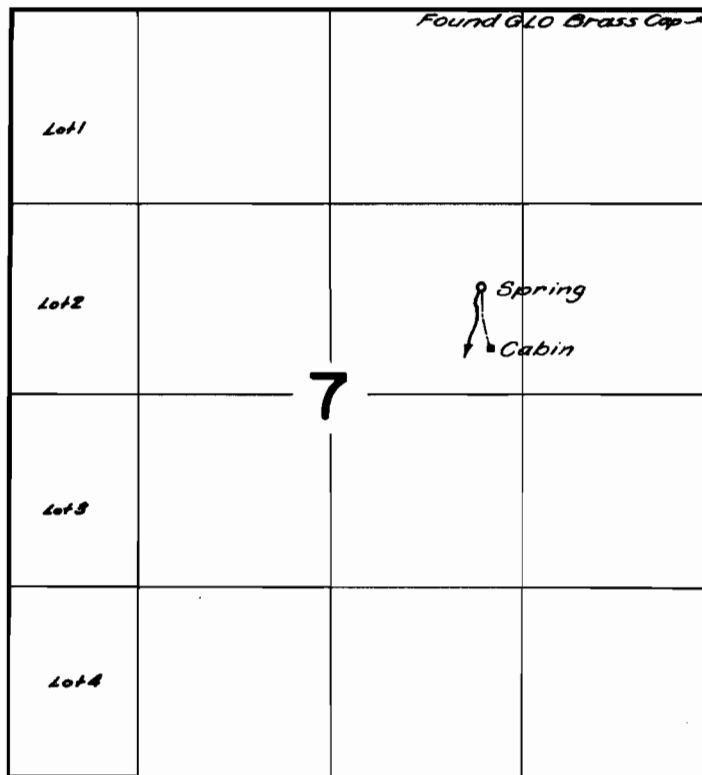

FINAL PROOF SURVEY UNDER

Application No. 32223 Permit No. 25665
IN NAME OF

Wy'East Climbers

Surveyed July 25 1961, by C.D. Bartlett