


T.3S.R.9E.W.M.

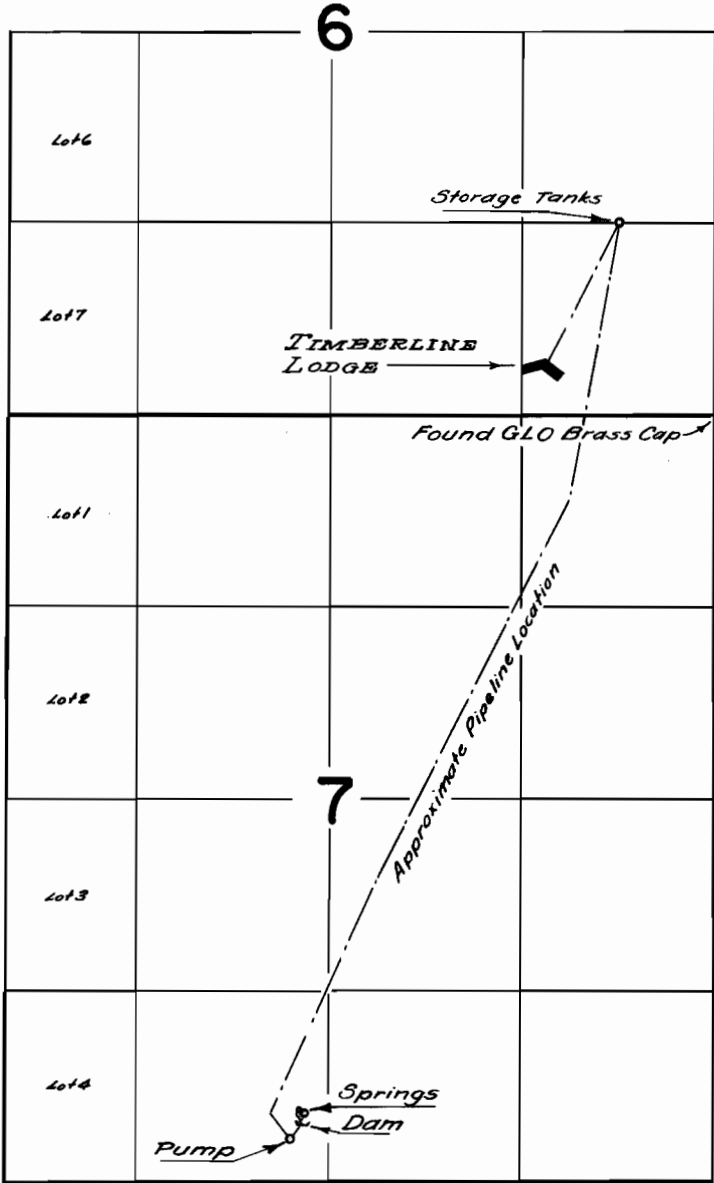

FINAL PROOF SURVEY UNDER

Application No. 32836 Permit No. 26057
IN NAME OF

U. S. FOREST SERVICE

Surveyed July 25 1961, by C. O. Bartels