


T.28S.R.14 W.W.M.

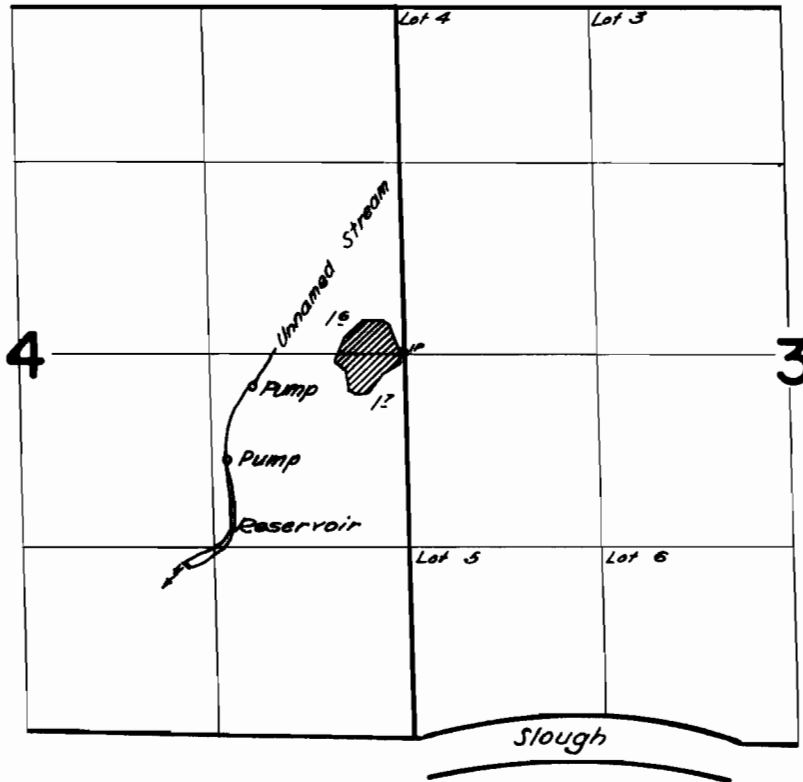

FINAL PROOF SURVEY UNDER

R-30709 R-1946
Application No. 30710 Permit No. 24531
IN NAME OF

D. C. RUDELL

Surveyed August 4, 1961, by C.O. Bartels