


# T.28S.R.II W.W.M.

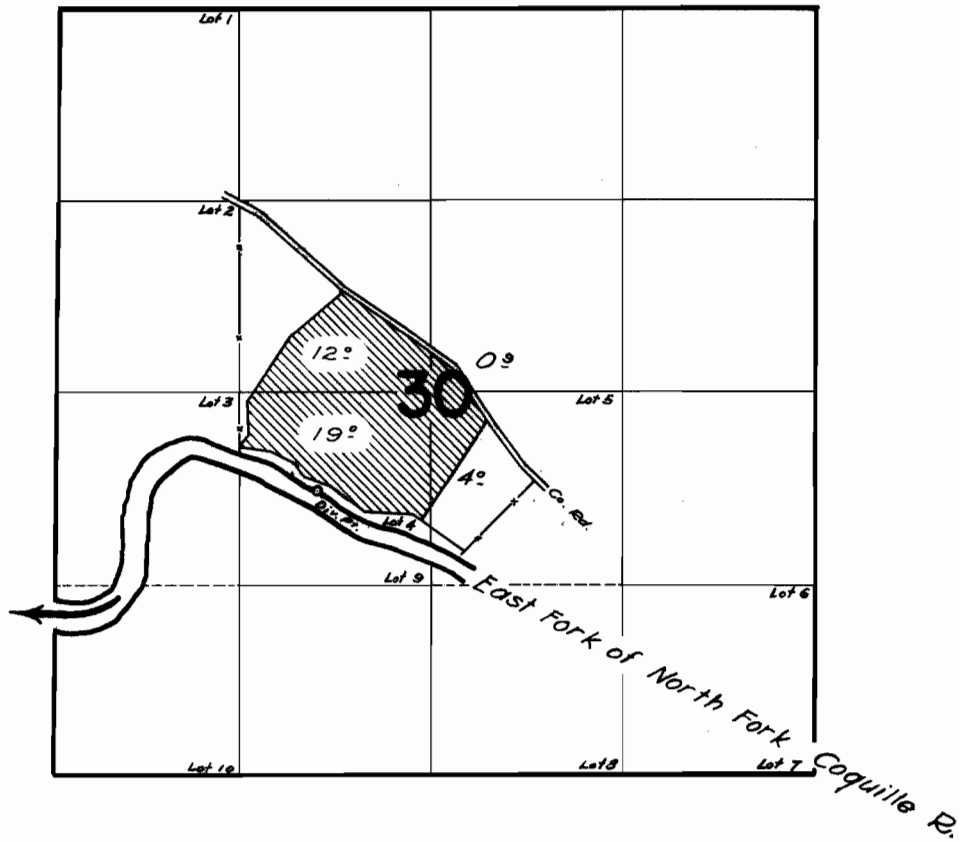

## FINAL PROOF SURVEY UNDER

Application No. **31752**..... Permit No. **25042**.....  
IN NAME OF

**E. L. CULBERTSON**

Surveyed *August 7, 1961*., by *C.O. Bartels*..