


T.28S.R.II W.W.M.

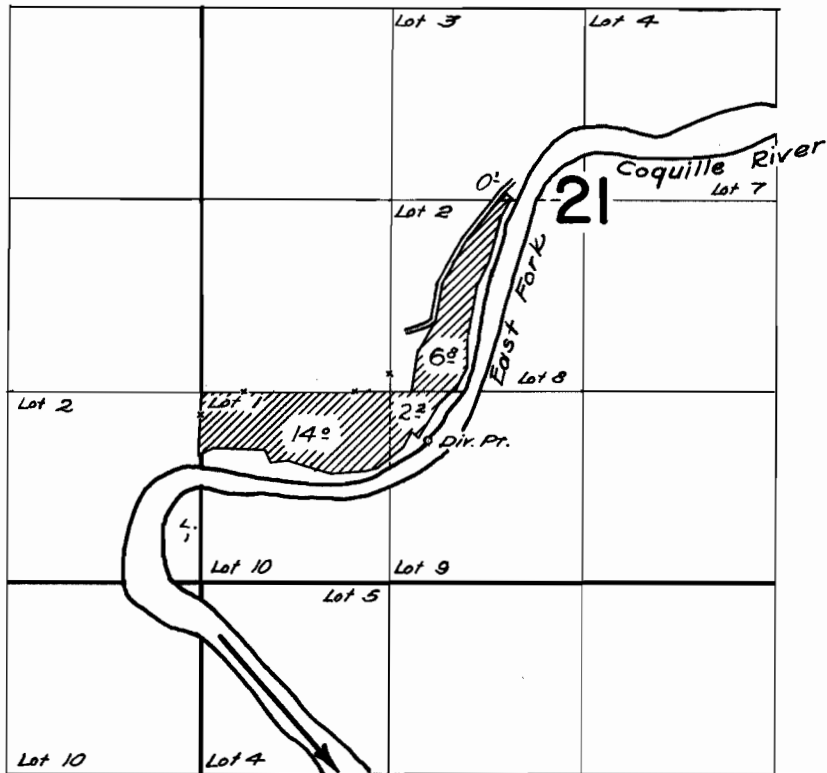

FINAL PROOF SURVEY UNDER

Application No. **32821**..... Permit No. **25905**.....
IN NAME OF

RAY A. POWELL

Surveyed *August 7*, 1961., by *C. O. Bartels*.....