


T. 35S. R. 11 W. W.M.

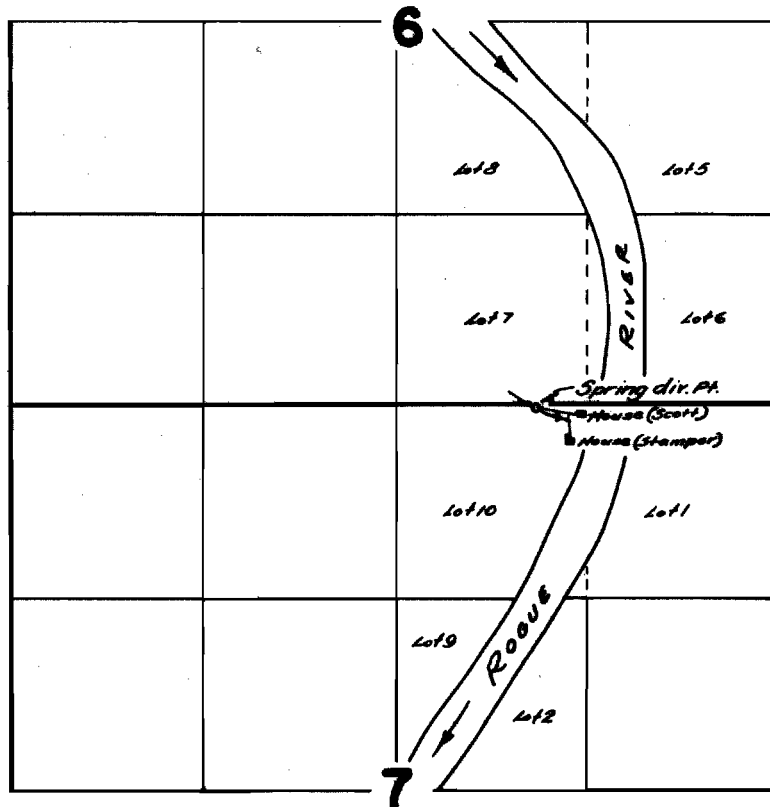

FINAL PROOF SURVEY

UNDER

Application No. 24410 Permit No. 19252

IN NAME OF

Charles W. Scott

Surveyed Aug. 27 19 61., by C. B. Smith