


T.33S.R.108^W11E.W.M.

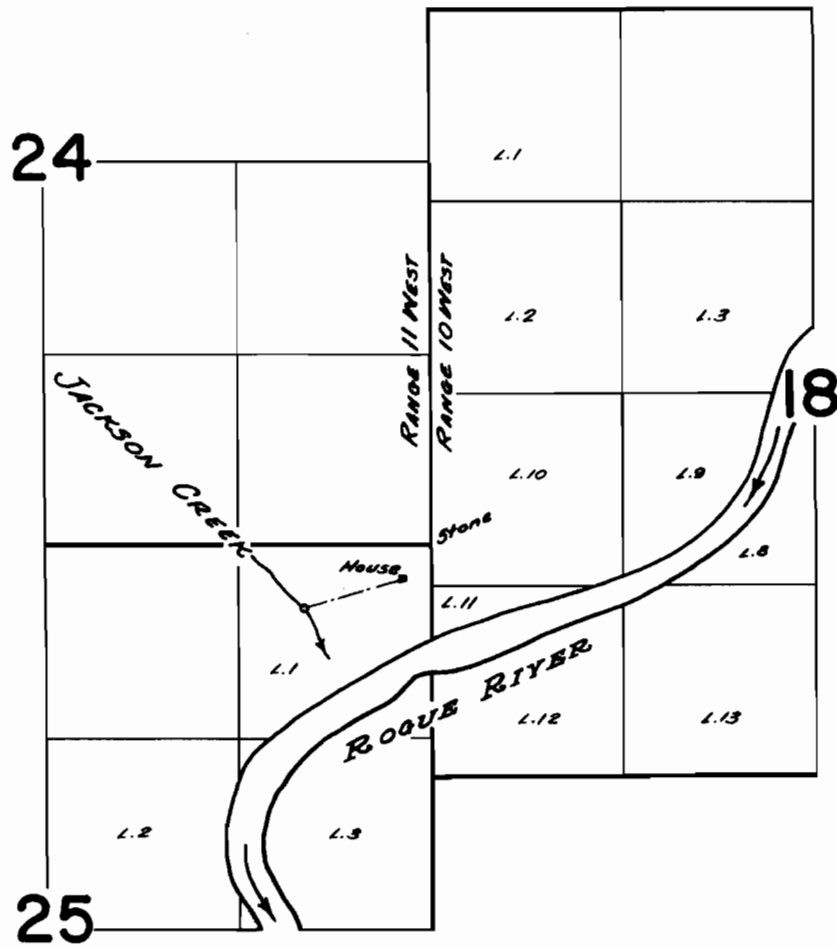

FINAL PROOF SURVEY
UNDER

Application No. 24711 Permit No. 12425
IN NAME OF

Odell Miller

Surveyed Aug. 23, 1961, by Collins