


T.36 S.R.15 W.W.M.

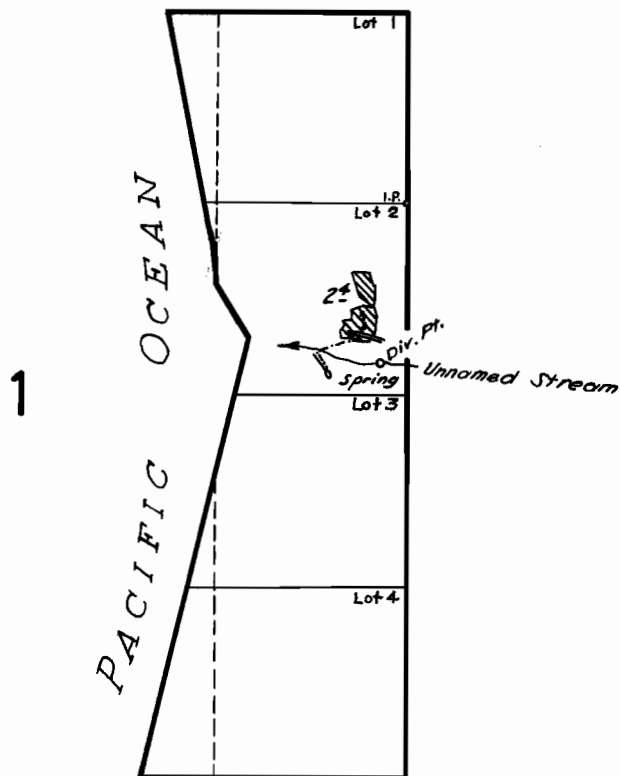

FINAL PROOF SURVEY
UNDER

Application No. 30967 Permit No. 24504
IN NAME OF

T. H. WIANCKO

Surveyed August 5, 1961, by L. Jackson