


T.41S. R.13 W.W.M.

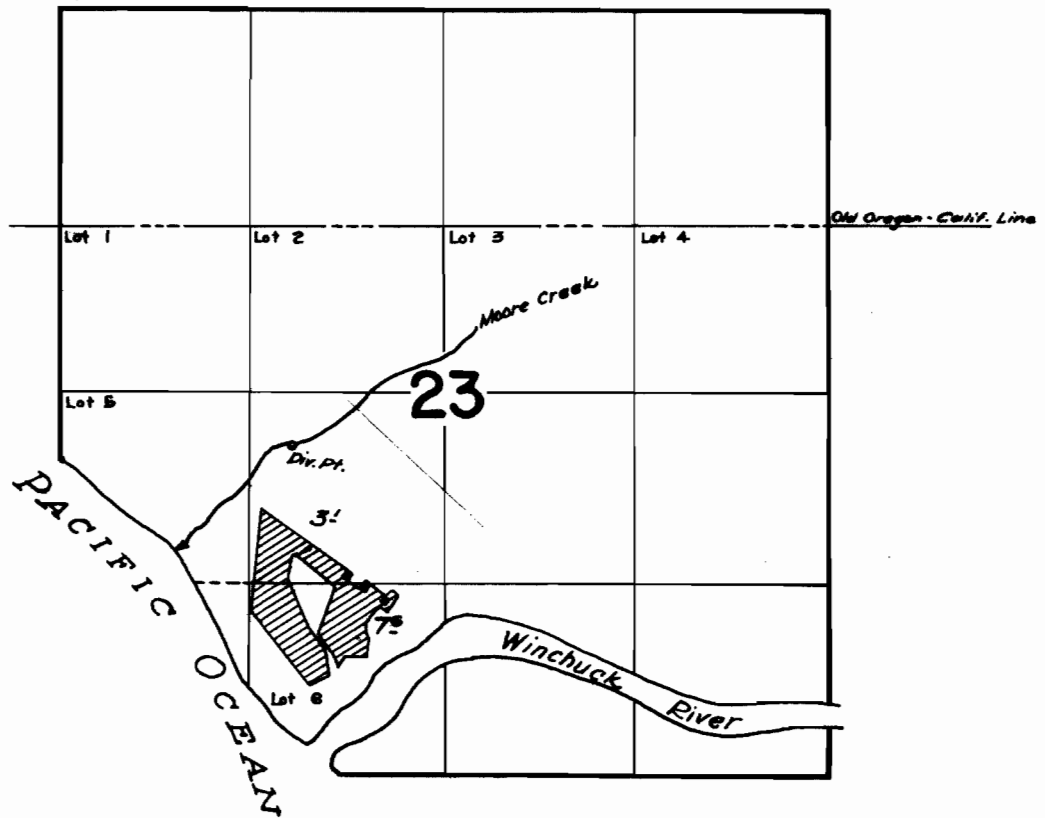

FINAL PROOF SURVEY
UNDER

Application No. **31157**..... Permit No. **24554**.....
IN NAME OF

RENA K. POTTS

Surveyed *August 4* 1961., by

[Signature]