


T. 33S. R. 10W. W.M.

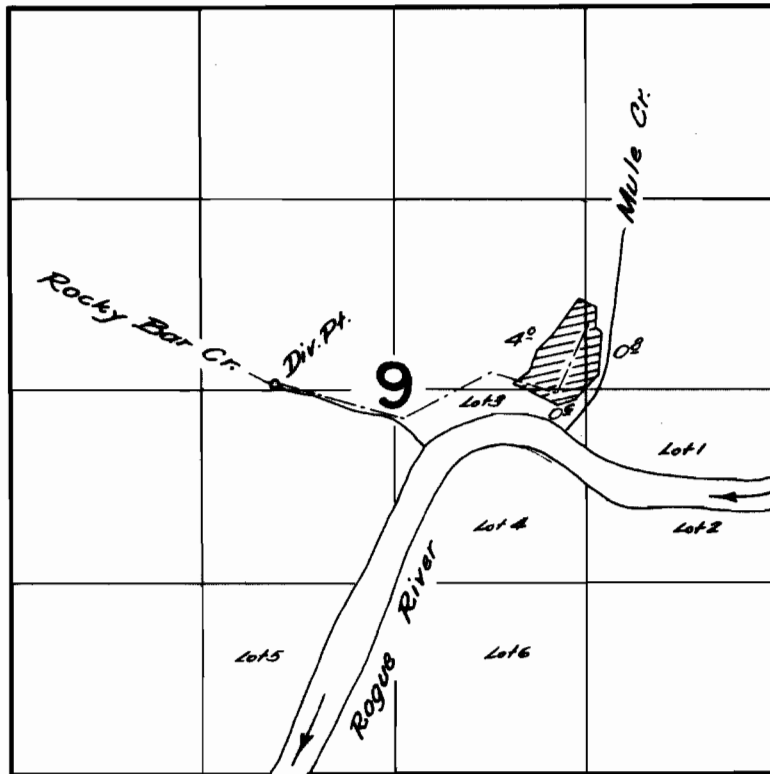

FINAL PROOF SURVEY

UNDER

Application No. 31899 Permit No. 25202

IN NAME OF

JACK ANDERSON

Surveyed Sept 25 19 61, by CC Smith