


T.35S.R.11W.W.M.

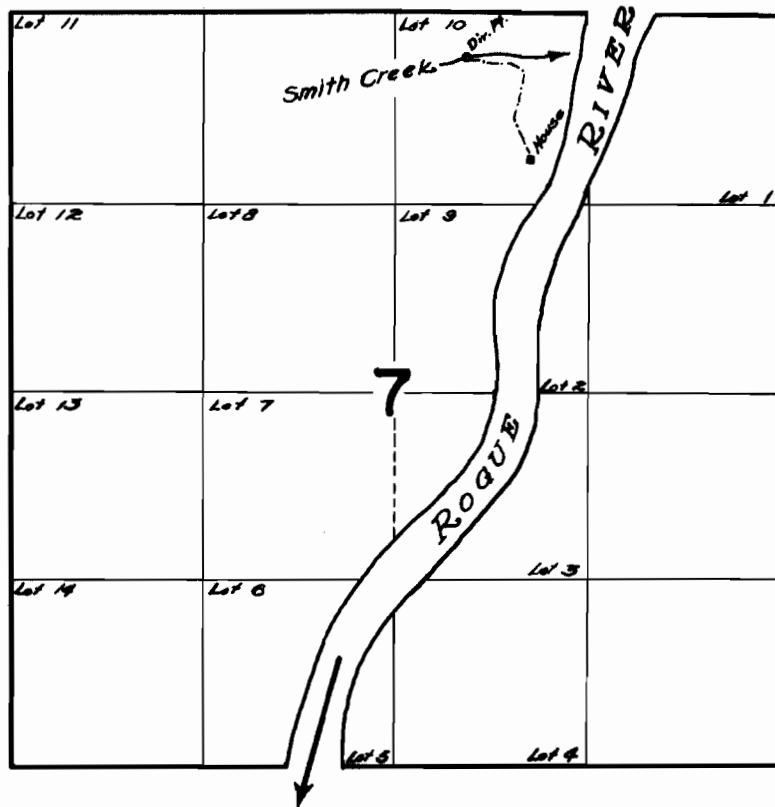

FINAL PROOF SURVEY UNDER

Application No. **31963**..... Permit No. **25213**.....
IN NAME OF

CLEO C. AND DORIS M. STRINGER

Surveyed *August 29* 1901., by *C. O. Bartels*..