


# T.34S.R.IIW.W.M.

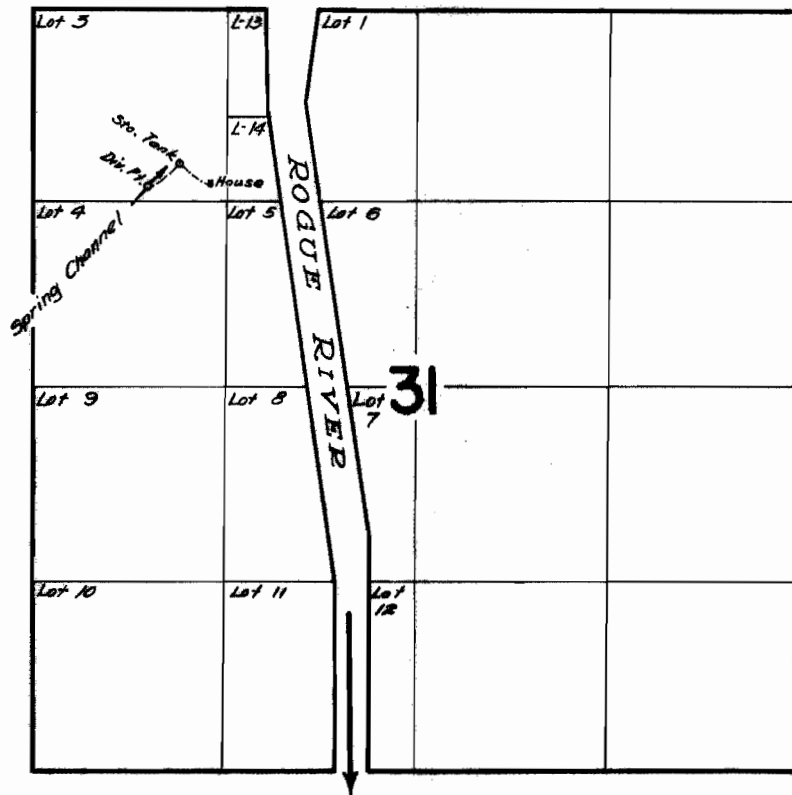

## FINAL PROOF SURVEY UNDER

Application No. **33963**... Permit No. **26867**...  
IN NAME OF

**EARL CHARLES AYERS & CHAROLETTE AYERS**

Surveyed *August 29 1961*., by *C. O. Bartels*.