


T.26S. R.6W.W.M.

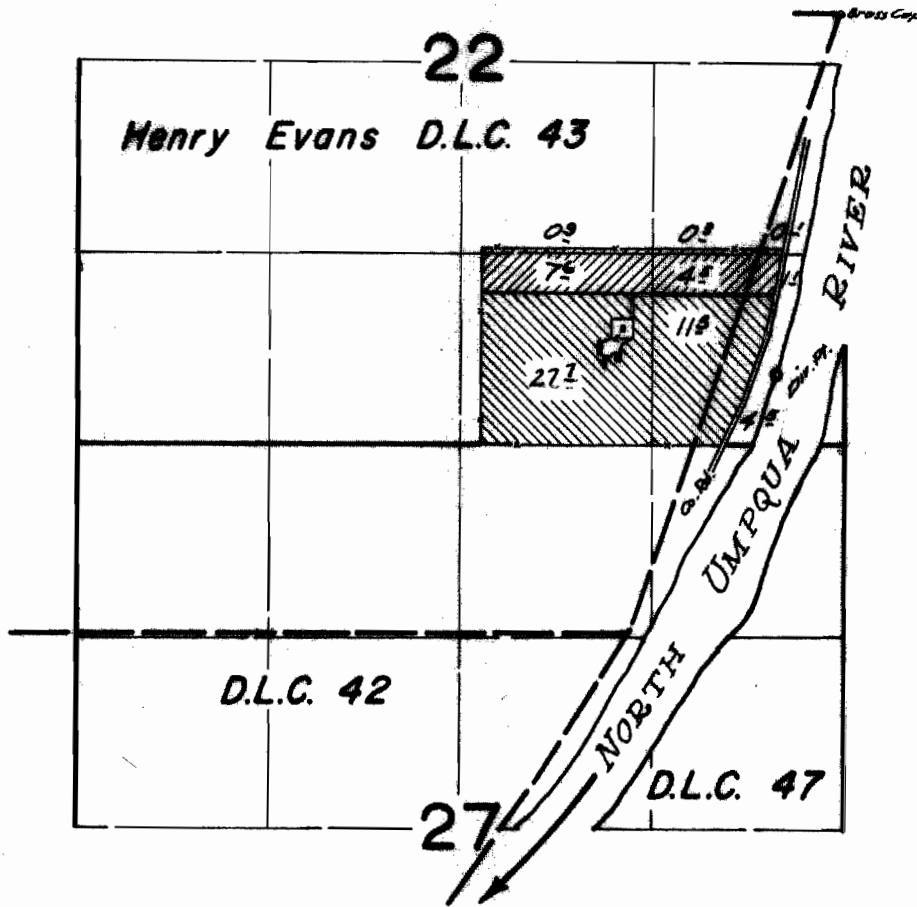

FINAL PROOF SURVEY
UNDER

Application No. **33099** Permit No. **26192** 
34000 **26788**

IN NAME OF

ROBERT A. DUDLEY

Surveyed *May 3* 1961, by *R. J. [Signature]*