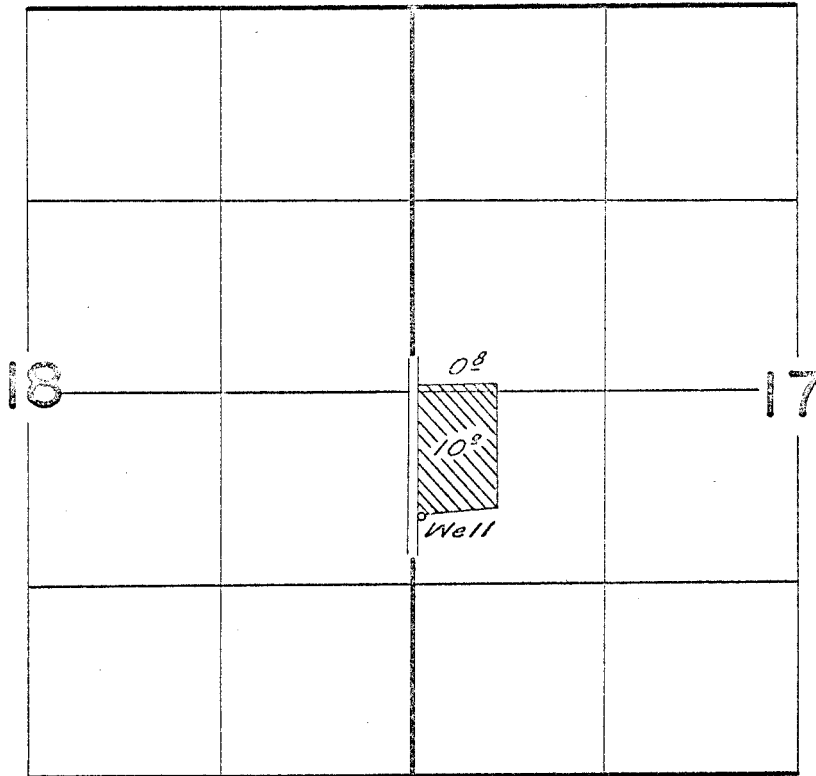


T.2N.R.20E.W.M.

FINAL PROOF SURVEY
UNDERApplication No. U-513... Permit No. U-514....
IN NAME OF
Estate of
Edward M. Hulden

Surveyed Oct. 3... 1961., by C.C. Bartels