


T.2N.R.21E.W.M.

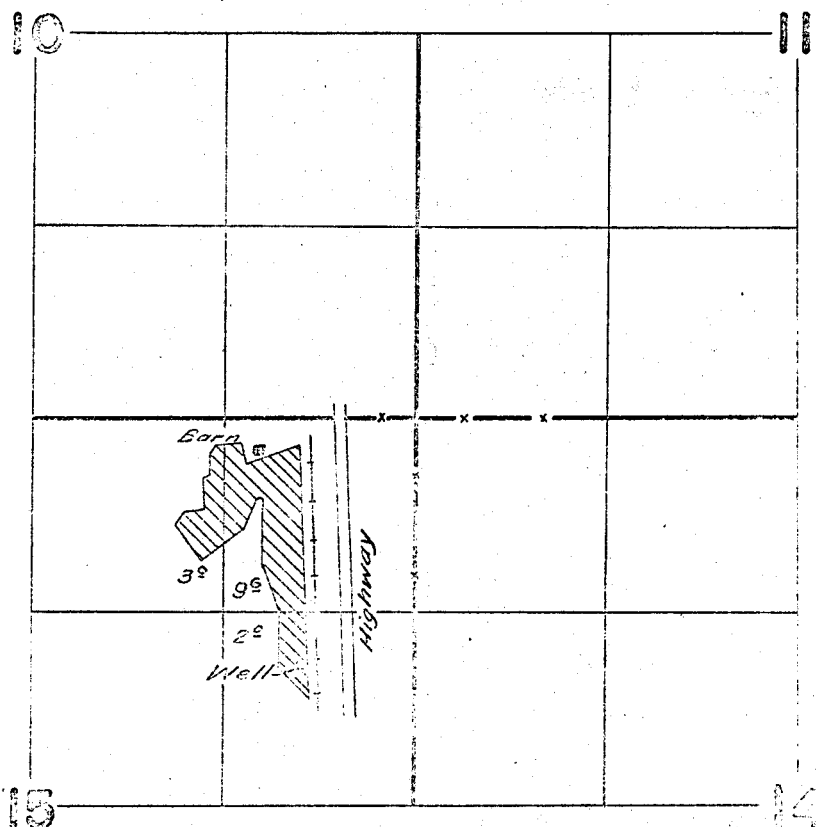

FINAL PROOF SURVEY
UNDER

Application No. U-731 Permit No. U-45
IN NAME OF

Halbert Lee & Ella L. Hoag

Surveyed Oct. 3 1961, by C. C. Smith