


T.1N. R. 22 E.W.M.

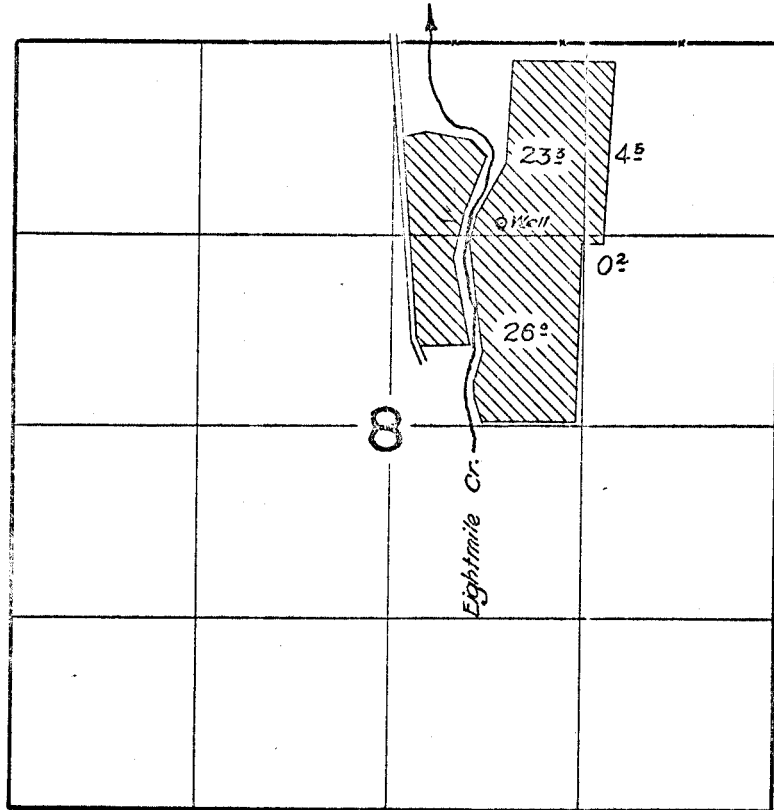

*Appl. # G-10536
 10" well
 Ladd Horn
 1555 ac.*

FINAL PROOF SURVEY UNDER

Application No. U-828... Permit No. U-730...
 IN NAME OF

D.L. & MARGARET S. LEMON

Surveyed *October 5 1961*., by *C.O. Bartels*.