


# T. IN. & S. R. 21 E. W. M.

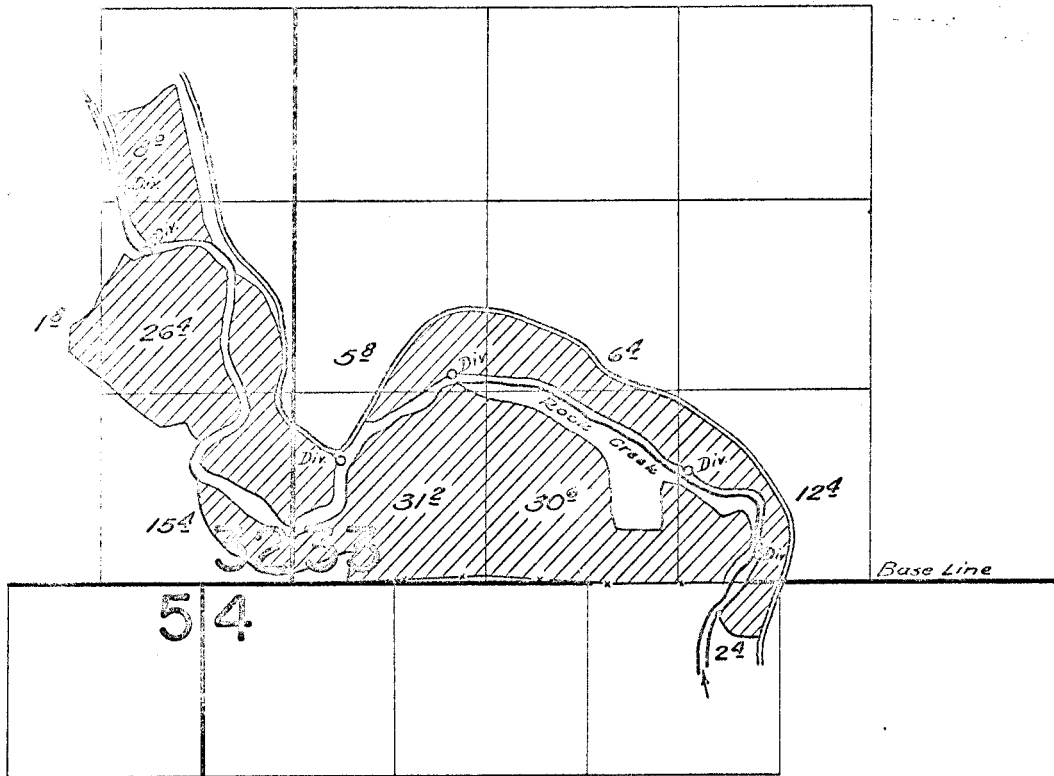

## FINAL PROOF SURVEY UNDER

Application No. 26470 Permit No. 21310  
IN NAME OF

FRANK M. WEATHERFORD

Surveyed Oct. 14 1961, by C. O. Baskin