


T.5S.R.21E.W.M.

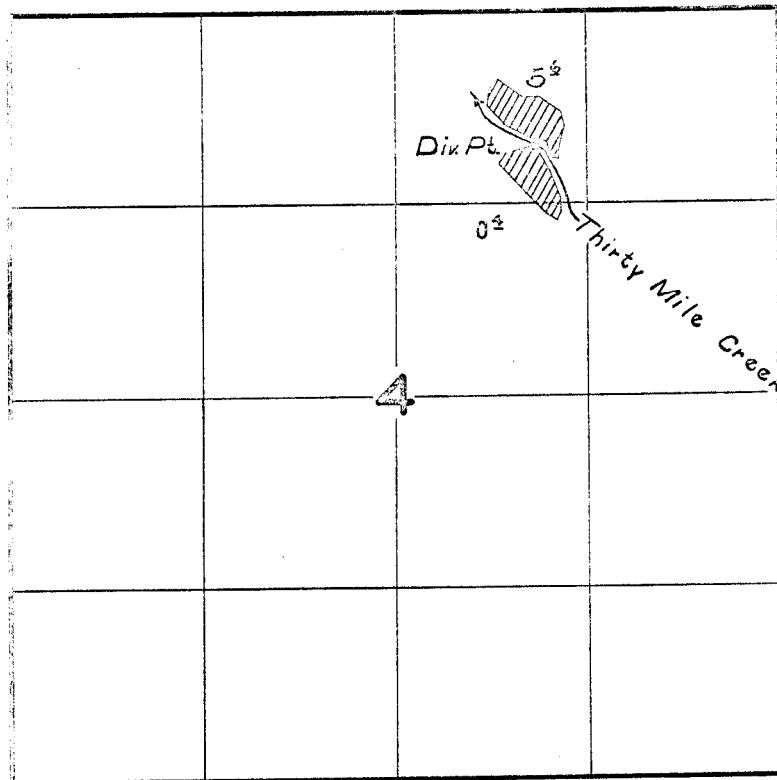

FINAL PROOF SURVEY
UNDER

Application No. 29351... Permit No. 23130...
IN NAME OF

ALEX D. & LETA D. HARDIE

Surveyed Oct. 6..... 1961., by C. O. BARTELS...